

1	LOCATION OF WATER WELL:	Fraction	Section	Number	Township	Number	Range	Number
	County: Finney	SW $\frac{1}{4}$ SW $\frac{1}{4}$ SW $\frac{1}{4}$		16		24		32 E/W


Distance and direction from nearest town or city street address of well If located within city?

Highway 50 & Campus Drive, Garden City

2 WATER WELL OWNER: COUNTRY CORNER

RR #, St. Address, Box #: HIGHWAY 50 & CAMPUS DRIVE
City, State, ZIP Code : GARDEN CITY, KS 67846Board of Agriculture, Division of Water Resources
Application Number:

3 MARK WELL'S LOCATION WITH AN "X" IN SECTION BOX:

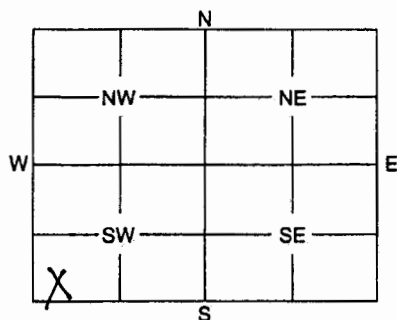

4 DEPTH OF WELL 41.8 ft.

WELL'S STATIC WATER LEVEL Dry ft.

WELL WAS USED AS:

- 1 Domestic
- 2 Irrigation
- 3 Feedlot
- 4 Industrial

- 5 Public Water Supply
- 6 Oil Field Water Supply
- 7 Domestic (Lawn & Garden)
- 8 Air Conditioning

- 9 Dewatering
- 10 Monitoring Well
- 11 Injection Well
- 12 Other

Was a chemical / bacteriological sample submitted to Department? Yes No
If yes, mo/day/yr sample was submittedWater Well Disinfected: Yes No☒

5 TYPE OF BLANK CASING USED:

- 1 Steel
- 3 RMP (SR)
- 5 Wrought
- 7 Fiberglass
- 9 Other (Specify below)
- 2 PVC
- 4 ABS
- 6 Asbestos-Cement
- 8 Concrete Tile

Blank casing diameter 2 in. Was casing pulled? Yes No
Casing height above or below land surface 30 in. If yes, how much *6 GROUT PLUG MATERIAL: 1 Neat cement 2 Cement grout • Bentonite • Other Native soil
Grout Plug Intervals: From 0 ft. to 1 ft., From 1 ft. to 40 ft., From to ft.

What is the nearest source of possible contamination:

- 1 Septic tank
- 2 Sewer lines
- 3 Watertight sewer lines
- 4 Lateral lines
- 5 Cess pool
- 6 Seepage pit
- 7 Pit privy
- 8 Sewage lagoon
- 9 Feedyard
- 10 Livestock pens
- 11 Fuel storage
- 12 Fertilizer storage
- 13 Insecticide storage
- 14 Abandoned water well
- 15 Oil well/Gas well
- 16 Other (specify below)

Direction from well? How many feet?

FROM	TO	PLUGGING MATERIALS
0	1	Native soil
1	3	Bentonite (8")
3	40	Bentonite (2")

Drilled out to 3'

MW1

KDHE #U1 028 00581 / GeoCore #943

7 CONTRACTOR'S OF LANDOWNER'S CERTIFICATION: This water well was plugged under my jurisdiction and was completed on (mo/day/year) 10/20/06 and this record is true to the best of my knowledge and belief. Kansas Water Well Contractor's License No. 527 This Water Well Record was completed on (mo/day/year) 10/31/06 under the business name of GeoCore Inc. by (signature) Dale Kahl

INSTRUCTIONS: Use typewriter or ball point pen. Please press firmly and print clearly. Please fill in blanks, underline or circle the correct answers. Send top three copies to Kansas Department of Health and Environment, Bureau of Water, Geology Section, 1000 SW Jackson St., Ste. 420, Topeka, Kansas 66612-1367. Telephone: 785/296-5522. Send one to Water Well Owner and retain one for your records.