

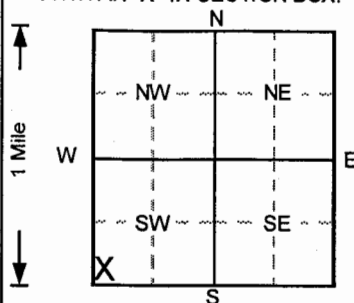
1 LOCATION OF WATER WELL: County: Finney	Fraction SW ¼ SW ¼ SW ¼	Section Number 16	Township Number T 24 S	Range Number R 32 E/W
--	-----------------------------------	-----------------------------	----------------------------------	---------------------------------

Distance and direction from nearest town or city street address of well if located within city?

Highway 50 & Campus Drive, Garden City2 WATER WELL OWNER: **Garden City Coop Inc.**RR#, St. Address, Box # : **P.O. Box 838**City, State, ZIP Code : **Garden City, Kansas 67846**

Board of Agriculture, Division of Water Resources

Application Number:

3 LOCATE WELL'S LOCATION
WITH AN "X" IN SECTION BOX:4 DEPTH OF COMPLETED WELL **55** ft. ELEVATION:

Depth(s) Groundwater Encountered 1. ft. 2. ft. 3. ft.

WELL'S STATIC WATER LEVEL **43.6** ft. below land surface measured on mo/day/yr **10/19/2006**Pump test data: Well water was **NA** ft. after hours pumping gpmEst. Yield **NA** gpm: Well water was ft. after hours pumping gpmBore Hole Diameter **8** in. to **55** ft., and in. to ft.

WELL WATER TO BE USED AS: 5 Public water supply 8 Air conditioning 11 Injection well

1 Domestic 3 Feedlot 6 Oil field water supply 9 Dewatering 12 Other (Specify below)

2 Irrigation 4 Industrial 7 Lawn and garden only **10** Monitoring wellWas a chemical/bacteriological sample submitted to Department? Yes.....No ☒ If yes, mo/day/yr sample was submittedWater Well Disinfected? Yes No ☒

5 TYPE OF BLANK CASING USED:

1 Steel 3 RMP (SR)

5 Wrought iron

8 Concrete tile

CASING JOINTS: Glued Clamped

2 PVC 4 ABS

6 Asbestos-Cement

9 Other (specify below)

Welded

Blank casing diameter **2** in. to **30** ft., Dia in. to ft., Dia in. to ft.Casing height above land surface **0** in., weight lbs./ft. Wall thickness or gauge No. **Sch. 40**

TYPE OF SCREEN OR PERFORATION MATERIAL

1 Steel 3 Stainless steel

5 Fiberglass

7 PVC

10 Asbestos-cement

2 Brass 4 Galvanized steel

6 Concrete tile

8 RMP (SR)

11 Other (specify)

12 None used (open hole)

SCREEN OR PERFORATION OPENINGS ARE:

1 Continuous slot **3** Mill slot

5 Gauzed wrapped

8 Saw cut

11 None (open hole)

2 Louvered shutter 4 Key punched

6 Wire wrapped

9 Drilled holes

7 Torch cut

10 Other (specify)

SCREEN-PERFORATED INTERVALS: From **30** ft. to **55** ft., From ft. to ft.

From ft. to ft., From ft. to ft.

GRAVEL PACK INTERVALS: From **28** ft. to **55** ft., From ft. to ft.

From ft. to ft., From ft. to ft.

6 GROUT MATERIAL: 1 Neat cement 2 Cement grout **3** Bentonite **4** Other ConcreteGrout intervals: From **0** ft. to **1** ft., From **1** ft. to **28** ft., From ft. to ft.

What is the nearest source of possible contamination:

1 Septic tank

4 Lateral lines

7 Pit privy

10 Livestock pens

14 Abandoned water well

2 Sewer lines

5 Cess pool

8 Sewage lagoon

11 Fuel storage

15 Oil well/Gas well

3 Watertight sewer lines 6 Seepage pit

9 Feedyard

12 Fertilizer storage

16 Other (specify below)

13 Insecticide storage

Direction from well?

How many feet?

FROM	TO	LITHOLOGIC LOG	FROM	TO	PLUGGING INTERVALS
0	0.5	Concrete,			
0.5	3	Clay, silty, moist, no odor, Dark Brown			
3	5	Clay, v. silty, sl. sandy, moist, Brown			
5	9	Sand (vf-m), sl. moist, no odor, Reddish Brow			
9	15	Sand (vf-f), sl. moist, no odor, Yellowish Brow			
15	20	Sand (f-c), silty, subrounded, moist, Brown			
20	27	Sand (f-c) w/f gravel, rd - sb rd, Brown			
27	34	Sand (f-c) w/f-m gravel, sb rd - rd, Brown			
34	42	Sand (f-c) w/f-c gravel, rd - sb rd, Brown			
42	54	Sand (f-c) w/f-c gravel, rd - sb rd, Brown			
54	55	Clay, sandy, silty, saturated, plastic, Lt. Brow			
					MW3R, Tag # 00375766, Flushmount
					Project Name: Country Corner
					GeoCore # 943, KDHE # U1 028 00581

7 CONTRACTOR'S OR LANDOWNER'S CERTIFICATION: This water well was **(1)** constructed, (2) reconstructed, or (3) plugged under my jurisdiction and was completed on (mo/day/year) **10/19/2006** and this record is true to the best of my knowledge and belief.Kansas Water Well Contractor's License No. **527** This Water Well Record was completed on (mo/day/yr) **10/31/06**

under the business name of

GeoCore, Inc.

by (signature)

Dale Bell