

FCM 9749

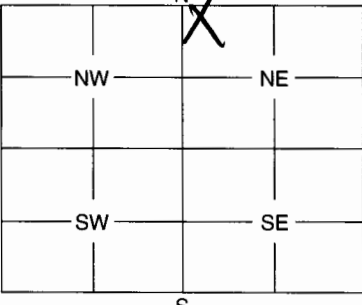
WATER WELL PLUGGING RECORD

Form WWC-5P

KSA 82a-1212

ID NO.

249466

| 1 | LOCATION OF WATER WELL: County: Finney | Fraction NW NW NE | Section Number 8 | Township Number 24 S | Range Number 32 W E/W | | | | | | | | | | | | | | | | | | | | | |
|--|--|--|---|--------------------------------|---------------------------------|---------------|-----------------------|--------------------|--------------------------|--------------------------|--------------------|-----------------------|----------------------------|--------------------------|-----------------|------------------------|----------|-----------------|------------|-------------------------|--|-------------|-------------------|----------------------|--|--|
| Distance and direction from nearest town or city street address of well if located within city? 2505 Fleming St, Garden City, KS | | | | | | | | | | | | | | | | | | | | | | | | | | |
| 2 | WATER WELL OWNER: Coastal Mart Inc #9749 MW-4R | | | | | | | | | | | | | | | | | | | | | | | | | |
| RR #, St. Address, Box #: City, State, ZIP Code : 2 N. Nevada Colo. Springs, CO 80903 | | Board of Agriculture, Division of Water Resources Application Number: | | | | | | | | | | | | | | | | | | | | | | | | |
| 3 | MARK WELL'S LOCATION WITH AN "X" IN SECTION BOX: <div style="text-align:center"></div> | | 4 DEPTH OF WELL 99.40 ft. WELL'S STATIC WATER LEVEL 91.77 ft. WELL WAS USED AS: <table border="0" style="width:100%"><tr><td>1 Domestic</td><td>5 Public Water Supply</td><td>9 Dewatering</td></tr><tr><td>2 Irrigation</td><td>6 Oil Field Water Supply</td><td>10 Monitoring Well</td></tr><tr><td>3 Feedlot</td><td>7 Domestic (Lawn & Garden)</td><td>11 Injection Well</td></tr><tr><td>4 Industrial</td><td>8 Air Conditioning</td><td>12 Other</td></tr></table> | | | 1 Domestic | 5 Public Water Supply | 9 Dewatering | 2 Irrigation | 6 Oil Field Water Supply | 10 Monitoring Well | 3 Feedlot | 7 Domestic (Lawn & Garden) | 11 Injection Well | 4 Industrial | 8 Air Conditioning | 12 Other | | | | | | | | | |
| 1 Domestic | 5 Public Water Supply | 9 Dewatering | | | | | | | | | | | | | | | | | | | | | | | | |
| 2 Irrigation | 6 Oil Field Water Supply | 10 Monitoring Well | | | | | | | | | | | | | | | | | | | | | | | | |
| 3 Feedlot | 7 Domestic (Lawn & Garden) | 11 Injection Well | | | | | | | | | | | | | | | | | | | | | | | | |
| 4 Industrial | 8 Air Conditioning | 12 Other | | | | | | | | | | | | | | | | | | | | | | | | |
| Was a chemical / bacteriological sample submitted to Department? Yes No X If yes, mo/day/yr sample was submitted Water Well Disinfected: Yes No X | | | | | | | | | | | | | | | | | | | | | | | | | | |
| 5 | TYPE OF BLANK CASING USED: <table border="0" style="width:100%"><tr><td>1 Steel</td><td>3 RMP (SR)</td><td>5 Wrought</td><td>7 Fiberglass</td><td>9 Other (Specify below)</td></tr><tr><td>2 PVC</td><td>4 ABS</td><td>6 Asbestos-Cement</td><td>8 Concrete Tile</td><td></td></tr></table> Blank casing diameter in. Was casing pulled? Yes X No If yes, how much 3' Casing height above or below land surface in. | | | | | 1 Steel | 3 RMP (SR) | 5 Wrought | 7 Fiberglass | 9 Other (Specify below) | 2 PVC | 4 ABS | 6 Asbestos-Cement | 8 Concrete Tile | | | | | | | | | | | | |
| 1 Steel | 3 RMP (SR) | 5 Wrought | 7 Fiberglass | 9 Other (Specify below) | | | | | | | | | | | | | | | | | | | | | | |
| 2 PVC | 4 ABS | 6 Asbestos-Cement | 8 Concrete Tile | | | | | | | | | | | | | | | | | | | | | | | |
| 6 | GROUT PLUG MATERIAL: 1 Neat cement 2 Cement grout 3 Bentonite 4 Other Grout Plug Intervals: From 0 ft. to 3 ft., From 3 ft. to 99.40 ft., From to ft. What is the nearest source of possible contamination: <table border="0" style="width:100%"><tr><td>1 Septic tank</td><td>6 Seepage pit</td><td>11 Fuel storage</td><td>16 Other (specify below)</td></tr><tr><td>2 Sewer lines</td><td>7 Pit privy</td><td>12 Fertilizer storage</td><td></td></tr><tr><td>3 Watertight sewer lines</td><td>8 Sewage lagoon</td><td>13 Insecticide storage</td><td></td></tr><tr><td>4 Lateral lines</td><td>9 Feedyard</td><td>14 Abandoned water well</td><td></td></tr><tr><td>5 Cess pool</td><td>10 Livestock pens</td><td>15 Oil well/Gas well</td><td></td></tr></table> Direction from well? West How many feet? 25' | | | | | 1 Septic tank | 6 Seepage pit | 11 Fuel storage | 16 Other (specify below) | 2 Sewer lines | 7 Pit privy | 12 Fertilizer storage | | 3 Watertight sewer lines | 8 Sewage lagoon | 13 Insecticide storage | | 4 Lateral lines | 9 Feedyard | 14 Abandoned water well | | 5 Cess pool | 10 Livestock pens | 15 Oil well/Gas well | | |
| 1 Septic tank | 6 Seepage pit | 11 Fuel storage | 16 Other (specify below) | | | | | | | | | | | | | | | | | | | | | | | |
| 2 Sewer lines | 7 Pit privy | 12 Fertilizer storage | | | | | | | | | | | | | | | | | | | | | | | | |
| 3 Watertight sewer lines | 8 Sewage lagoon | 13 Insecticide storage | | | | | | | | | | | | | | | | | | | | | | | | |
| 4 Lateral lines | 9 Feedyard | 14 Abandoned water well | | | | | | | | | | | | | | | | | | | | | | | | |
| 5 Cess pool | 10 Livestock pens | 15 Oil well/Gas well | | | | | | | | | | | | | | | | | | | | | | | | |
| <table border="1" style="width:100%"><thead><tr><th>FROM</th><th>TO</th><th>PLUGGING MATERIALS</th></tr></thead><tbody><tr><td>0</td><td>3</td><td>Cement</td></tr><tr><td>3</td><td>99.40</td><td>Bentonite</td></tr><tr><td> </td><td> </td><td> </td></tr><tr><td> </td><td> </td><td> </td></tr><tr><td> </td><td> </td><td> </td></tr><tr><td> </td><td> </td><td> </td></tr></tbody></table> | | | | | | FROM | TO | PLUGGING MATERIALS | 0 | 3 | Cement | 3 | 99.40 | Bentonite | | | | | | | | | | | | |
| FROM | TO | PLUGGING MATERIALS | | | | | | | | | | | | | | | | | | | | | | | | |
| 0 | 3 | Cement | | | | | | | | | | | | | | | | | | | | | | | | |
| 3 | 99.40 | Bentonite | | | | | | | | | | | | | | | | | | | | | | | | |
| | | | | | | | | | | | | | | | | | | | | | | | | | | |
| | | | | | | | | | | | | | | | | | | | | | | | | | | |
| | | | | | | | | | | | | | | | | | | | | | | | | | | |
| | | | | | | | | | | | | | | | | | | | | | | | | | | |
| 7 | CONTRACTOR'S OF LANDOWNER'S CERTIFICATION: This water well was plugged under my jurisdiction and was completed on (mo/day/year) 2/21/2007 and this record is true to the best of my knowledge and belief. Kansas Water Well Contractor's License No. nla This Water Well Record was completed on (mo/day/year) 2/27/2007 under the business name of MWH Americas Inc by (signature) Buster L Dohlinger | | | | | | | | | | | | | | | | | | | | | | | | | |
| INSTRUCTIONS: Use typewriter or ball point pen. Please press firmly and print clearly. Please fill in blanks, underline or circle the correct answers. Send top three copies to Kansas Department of Health and Environment, Bureau of Water, Geology Section, 1000 SW Jackson St., Ste. 420, Topeka, Kansas 66612-1367. Telephone: 785/296-5522. Send one to Water Well Owner and retain one for your records. | | | | | | | | | | | | | | | | | | | | | | | | | | |