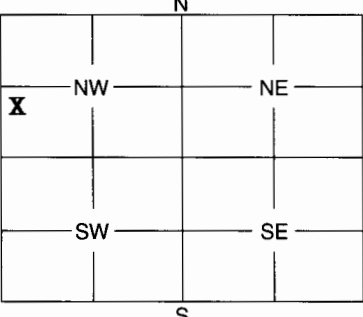


1	LOCATION OF WATER WELL: Finney County:	Fraction NW¹/₄ SW¹/₄ NW¹/₄	Section 22	Number	Township 24	Number	Range 32	Number																									
Distance and direction from nearest town or city street address of well if located within city? E. side of Garden City, 1½ M. East, 1 M. South, 3,720 ft. north & 5200 ft. west																																	
2	WATER WELL OWNER: William Mai Family Trust c/o Harold Mai RR #, St. Address, Box #: 1155 N. Anderson Road City, State, ZIP Code: Garden City, KS 67846 Board of Agriculture, Division of Water Resources Application Number Vested Right File No. FI070 Water Right File No. 3,715																																
3	MARK WELL'S LOCATION WITH AN "X" IN SECTION BOX: 		4 DEPTH OF WELL 220 ft. WELL'S STATIC WATER LEVEL 31 ft. WELL WAS USED AS: <table style="width:100%;"> <tr> <td>1 Domestic</td> <td>5 Public Water Supply</td> <td>9 Dewatering</td> </tr> <tr> <td>2 Irrigation</td> <td>6 Oil Field Water Supply</td> <td>10 Monitoring Well</td> </tr> <tr> <td>3 Feedlot</td> <td>7 Domestic (Lawn & Garden)</td> <td>11 Injection Well</td> </tr> <tr> <td>4 Industrial</td> <td>8 Air Conditioning</td> <td>12 Other</td> </tr> </table> Was a chemical / bacteriological sample submitted to Department? Yes No X If yes, mo/day/yr sample was submitted Water Well Disinfected: Yes X No							1 Domestic	5 Public Water Supply	9 Dewatering	2 Irrigation	6 Oil Field Water Supply	10 Monitoring Well	3 Feedlot	7 Domestic (Lawn & Garden)	11 Injection Well	4 Industrial	8 Air Conditioning	12 Other												
1 Domestic	5 Public Water Supply	9 Dewatering																															
2 Irrigation	6 Oil Field Water Supply	10 Monitoring Well																															
3 Feedlot	7 Domestic (Lawn & Garden)	11 Injection Well																															
4 Industrial	8 Air Conditioning	12 Other																															
5	TYPE OF BLANK CASING USED: 1 Steel 3 RMP (SR) 5 Wrought 7 Fiberglass 9 Other (Specify below) 2 PVC 4 ABS 6 Asbestos-Cement 8 Concrete Tile Blank casing diameter 16 in. Was casing pulled? Yes No X If yes, how much Casing height above or below land surface 36 in. below																																
6	GROUT PLUG MATERIAL: 1 Neat cement 2 Cement grout 3 Bentonite 4 Other Grout Plug Intervals: From 0 ft. to 3 ft., From ft. to ft., From to ft. What is the nearest source of possible contamination: <table style="width:100%;"> <tr> <td>1 Septic tank</td> <td>6 Seepage pit</td> <td>11 Fuel storage</td> <td>16 Other (specify below)</td> </tr> <tr> <td>2 Sewer lines</td> <td>7 Pit privy</td> <td>12 Fertilizer storage</td> <td></td> </tr> <tr> <td>3 Watertight sewer lines</td> <td>8 Sewage lagoon</td> <td>13 Insecticide storage</td> <td></td> </tr> <tr> <td>4 Lateral lines</td> <td>9 Feedyard</td> <td>14 Abandoned water well</td> <td>N/A</td> </tr> <tr> <td>5 Cess pool</td> <td>10 Livestock pens</td> <td>15 Oil well/Gas well</td> <td></td> </tr> </table> Direction from well? How many feet?									1 Septic tank	6 Seepage pit	11 Fuel storage	16 Other (specify below)	2 Sewer lines	7 Pit privy	12 Fertilizer storage		3 Watertight sewer lines	8 Sewage lagoon	13 Insecticide storage		4 Lateral lines	9 Feedyard	14 Abandoned water well	N/A	5 Cess pool	10 Livestock pens	15 Oil well/Gas well					
1 Septic tank	6 Seepage pit	11 Fuel storage	16 Other (specify below)																														
2 Sewer lines	7 Pit privy	12 Fertilizer storage																															
3 Watertight sewer lines	8 Sewage lagoon	13 Insecticide storage																															
4 Lateral lines	9 Feedyard	14 Abandoned water well	N/A																														
5 Cess pool	10 Livestock pens	15 Oil well/Gas well																															
<table border="1" style="width:100%; border-collapse: collapse;"> <thead> <tr> <th style="width:10%;">FROM</th> <th style="width:10%;">TO</th> <th style="width:80%;">PLUGGING MATERIALS</th> </tr> </thead> <tbody> <tr> <td>0'</td> <td>3'</td> <td>Top soil</td> </tr> <tr> <td>3'</td> <td>70'</td> <td>Cement Grout</td> </tr> <tr> <td>70'</td> <td>220'</td> <td>Chlorinated Gravel</td> </tr> <tr><td> </td><td> </td><td> </td></tr> <tr><td> </td><td> </td><td> </td></tr> <tr><td> </td><td> </td><td> </td></tr> <tr><td> </td><td> </td><td> </td></tr> </tbody> </table>										FROM	TO	PLUGGING MATERIALS	0'	3'	Top soil	3'	70'	Cement Grout	70'	220'	Chlorinated Gravel												
FROM	TO	PLUGGING MATERIALS																															
0'	3'	Top soil																															
3'	70'	Cement Grout																															
70'	220'	Chlorinated Gravel																															
7	CONTRACTOR'S OF LANDOWNER'S CERTIFICATION: This water well was plugged under my jurisdiction and was completed on (mo/day/year) 3-28-07 and this record is true to the best of my knowledge and belief. Kansas Water Well Contractor's License No. 208 This Water Well Record was completed on (mo/day/year) 4-3-07 under the business name of Minter-Wilson Drilling Co., Inc. by (signature) <i>Nora Kell...</i>																																

INSTRUCTIONS: Use typewriter or ball point pen. Please press firmly and print clearly. Please fill in blanks, underline or circle the correct answers. Send top three copies to Kansas Department of Health and Environment, Bureau of Water, Geology Section, 1000 SW Jackson St., Ste. 420, Topeka, Kansas 66612-1367. Telephone: 785/296-5522. Send one to Water Well Owner and retain one for your records.