

CORRECTION(S) TO WATER WELL RECORD (WWC-5)

(to rectify lacking or incorrect information)

Location listed as:

Section-Township-Range: None Given

Fraction ($\frac{1}{4}$ $\frac{1}{4}$ $\frac{1}{4}$): _____

County: Finney

Location changed to:

19-24S-32W

NW NW SE

Other changes: Initial statements: _____

Changed to: _____

Comments: _____

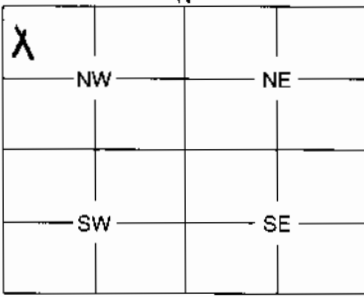
verification method: Well address, city street map, and

mapping tool on KGS website.

initials: ERA date: 6/11/2008

submitted by: Kansas Geological Survey, Data Resources Library, 1930 Constant Ave., Lawrence, KS 66047-3726

to: Kansas Dept of Health & Environment, Bureau of Water, 1000 SW Jackson, Suite 420, Topeka, KS 66612-1367.

1	LOCATION OF WATER WELL:	Fraction <div style="display: flex; justify-content: space-around;">1/41/41/4</div>	Section Number	Township Number	Range Number																								
County: <u>Finney</u> E/W																													
Distance and direction from nearest town or city street address of well if located within city? <div style="text-align: center;"><u>502 Buffalo Dr.</u></div>																													
2	WATER WELL OWNER: <u>Margaret Kingston</u>																												
RR #, St. Address, Box #:		Board of Agriculture, Division of Water Resources																											
City, State, ZIP Code: <u>Garden City, Mo. 67846</u>		Application Number:																											
3	MARK WELL'S LOCATION WITH AN "X" IN SECTION BOX:																												
<div style="display: flex; align-items: center;"> <div style="text-align: center; margin-right: 10px;"> N  W S </div> <div> DEPTH OF WELL <u>160</u> ft. WELL'S STATIC WATER LEVEL <u>78</u> ft. WELL WAS USED AS: <div style="display: flex; justify-content: space-between;"> <div> 1 Domestic 2 Irrigation 3 Feedlot 4 Industrial </div> <div> <input checked="" type="checkbox"/> Public Water Supply 6 Oil Field Water Supply 7 Domestic (Lawn & Garden) 8 Air Conditioning </div> <div> 9 Dewatering 10 Monitoring Well 11 Injection Well 12 Other </div> </div> </div> </div>																													
Was a chemical / bacteriological sample submitted to Department? Yes <input checked="" type="checkbox"/> No <input checked="" type="checkbox"/>																													
If yes, mo/day/yr sample was submitted																													
Water Well Disinfected: Yes <input checked="" type="checkbox"/> No																													
5	TYPE OF BLANK CASING USED:																												
<div style="display: flex; justify-content: space-between;"> <div> 1 Steel <input checked="" type="checkbox"/> PVC </div> <div> 3 RMP (SR) 4 ABS </div> <div> 5 Wrought 6 Asbestos-Cement </div> <div> 7 Fiberglass 8 Concrete Tile </div> <div> 9 Other (Specify below) </div> </div>																													
Blank casing diameter <u>5</u> in. Was casing pulled? Yes No <input checked="" type="checkbox"/> If yes, how much <u>Collapsed</u>																													
Casing height above or below land surface <u>5</u> in.																													
6	GROUT PLUG MATERIAL: 1 Neat cement 2 Cement grout <input checked="" type="checkbox"/> Bentonite 4 Other																												
Grout Plug Intervals: From <u>5</u> ft. to <u>160</u> ft., From to , From to ft.																													
What is the nearest source of possible contamination:																													
<div style="display: flex; justify-content: space-between;"> <div> 1 Septic tank 2 Sewer lines 3 Watertight sewer lines 4 Lateral lines 5 Cess pool </div> <div> 6 Seepage pit 7 Pit privy 8 Sewage lagoon 9 Feedyard 10 Livestock pens </div> <div> 11 Fuel storage 12 Fertilizer storage 13 Insecticide storage 14 Abandoned water well 15 Oil well/Gas well </div> <div> 16 Other (specify below) </div> </div>																													
Direction from well? How many feet?																													
<table border="1" style="width:100%; border-collapse: collapse;"> <thead> <tr> <th style="width:10%;">FROM</th> <th style="width:10%;">TO</th> <th style="width:80%;">PLUGGING MATERIALS</th> </tr> </thead> <tbody> <tr> <td><u>5</u></td> <td><u>160</u></td> <td><u>Bentonite</u></td> </tr> <tr><td> </td><td> </td><td> </td></tr> <tr><td> </td><td> </td><td> </td></tr> <tr><td> </td><td> </td><td> </td></tr> <tr><td> </td><td> </td><td> </td></tr> <tr><td> </td><td> </td><td> </td></tr> <tr><td> </td><td> </td><td> </td></tr>
7	CONTRACTOR'S OF LANDOWNER'S CERTIFICATION: This water well was plugged under my jurisdiction and was completed on (mo/day/year) <u>6-1-07</u> and this record is true to the best of my knowledge and belief. Kansas Water Well Contractor's License No. <u>172</u> This Water Well Record was completed on (mo/day/year) <u>8-1-08</u> under the business name of <u>Jonagan Water Well Service, LLC</u> by (signature) <u>S-1-08</u>																												
INSTRUCTIONS: Use typewriter or ball point pen. Please press firmly and print clearly. Please fill in blanks, underline or circle the correct answers. Send top three copies to Kansas Department of Health and Environment, Bureau of Water, Geology Section, 1000 SW Jackson St., Ste. 420, Topeka, Kansas 66612-1367. Telephone: 785/296-5522. Send one to Water Well Owner and retain one for your records.																													