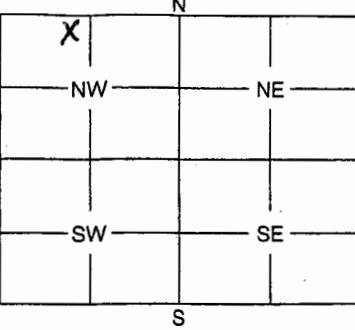


1	LOCATION OF WATER WELL:	Fraction County: Finney NE ^{1/4} NW ^{1/4} NW ^{1/4}	Section Number 18	Township Number 24	Range Number 32 EW																		
Distance and direction from nearest town or city street address of well if located within city? 601 W. Kansas Ave. Garden City KS 67846																							
2	WATER WELL OWNER: Burt's Motor Co. RR #, St. Address, Box #: 601 W. Kansas Ave. City, State, ZIP Code : Garden City KS 67846	Board of Agriculture, Division of Water Resources Application Number:																					
3	MARK WELL'S LOCATION WITH AN "X" IN SECTION BOX:	4	DEPTH OF WELL 34 ft.	WELL'S STATIC WATER LEVEL ft.																			
			WELL WAS USED AS:	1 Domestic 5 Public Water Supply 2 Irrigation 6 Oil Field Water Supply 3 Feedlot 7 Domestic (Lawn & Garden) 4 Industrial 8 Air Conditioning 9 Dewatering 10 Monitoring Well 11 Injection Well 12 Other																			
Was a chemical / bacteriological sample submitted to Department? Yes No <input checked="" type="checkbox"/> If yes, mo/day/yr sample was submitted																							
Water Well Disinfected: Yes No <input checked="" type="checkbox"/>																							
5	TYPE OF BLANK CASING USED:																						
1 Steel 3 RMP (SR) 5 Wrought 7 Fiberglass 9 Other (Specify below) <input checked="" type="checkbox"/> 2 PVC 4 ABS 6 Asbestos-Cement 8 Concrete Tile																							
Blank casing diameter 2 in.		Was casing pulled? Yes <input checked="" type="checkbox"/> No If yes, how much 3'																					
Casing height above or below land surface in.																							
6	GROUT PLUG MATERIAL: 1 Neat cement 2 Cement grout 3 Bentonite 4 Other Grout Plug Intervals: From 3 ft. to 34 ft., From ft. to ft., From ft. to ft.																						
What is the nearest source of possible contamination:																							
1 Septic tank 6 Seepage pit 11 Fuel storage 16 Other (specify below) 2 Sewer lines 7 Pit privy 12 Fertilizer storage 3 Watertight sewer lines 8 Sewage lagoon 13 Insecticide storage 4 Lateral lines 9 Feedyard 14 Abandoned water well 5 Cess pool 10 Livestock pens 15 Oil well/Gas well																							
Direction from well? How many feet?																							
<table border="1"> <thead> <tr> <th>FROM</th> <th>TO</th> <th>PLUGGING MATERIALS</th> </tr> </thead> <tbody> <tr> <td>0'</td> <td>3'</td> <td>Native Material</td> </tr> <tr> <td>3'</td> <td>34'</td> <td>Bentonite Chips</td> </tr> <tr> <td colspan="3">KDHE Project Code 41-028-00189</td> </tr> <tr> <td colspan="3"></td> </tr> <tr> <td colspan="3"></td> </tr> </tbody> </table>						FROM	TO	PLUGGING MATERIALS	0'	3'	Native Material	3'	34'	Bentonite Chips	KDHE Project Code 41-028-00189								
FROM	TO	PLUGGING MATERIALS																					
0'	3'	Native Material																					
3'	34'	Bentonite Chips																					
KDHE Project Code 41-028-00189																							
7	CONTRACTOR'S OF LANDOWNER'S CERTIFICATION: This water well was plugged under my jurisdiction and was completed on (mo/day/year) 8-25-08 and this record is true to the best of my knowledge and belief. Kansas Water Well Contractor's License No. 9-12-08 under the business name of Green Field Contractors. This Water Well Record was completed on (mo/day/year) by (signature) John F. Fehlstrom																						

INSTRUCTIONS: Use typewriter or ball point pen. Please press firmly and print clearly. Please fill in blanks, underline or circle the correct answers. Send top three copies to Kansas Department of Health and Environment, Bureau of Water, Geology Section, 1000 SW Jackson St., Ste. 420, Topeka, Kansas 66612-1367. Telephone: 785/296-5522. Send one to Water Well Owner and retain one for your records.