

**CORRECTION(S) TO WATER WELL RECORD (WWC-5)**  
(to rectify lacking or incorrect information)

Location listed as:

Section-Township-Range: 18-245-36 W

Fraction ( $\frac{1}{4}$   $\frac{1}{4}$   $\frac{1}{4}$ ): NE NW NW

County: Finney  
Location changed to:

18-245-32 W

NE NW NW

Other changes: Initial statements: \_\_\_\_\_

Changed to: \_\_\_\_\_

Comments: \_\_\_\_\_

verification method: Well address, city street map, other monitoring well records for same owner, position on plat map, and mapping tool on KGS website. initials: DR date: 12/3/2008

submitted by: Kansas Geological Survey, Data Resources Library, 1930 Constant Ave., Lawrence, KS 66047-3726

to: Kansas Dept of Health & Environment, Bureau of Water, 1000 SW Jackson, Suite 420, Topeka, KS 66612-1367.

## WATER WELL RECORD Form WWC-5 KSA 82a-1212


1 LOCATION OF WATER WELL:	Fraction County: Finney NE 1/4 NW 1/4 NW 1/4	Section Number 18	Township Number T 24 S	Range Number R 36 E/W
---------------------------	--	----------------------	---------------------------	--------------------------

Distance and direction from nearest town or city street address of well if located within city?

601 W. Kansas, Garden City

2 WATER WELL OWNER: Burtis Motor RR#, St. Address, Box # : 601 W. Kansas City, State, ZIP Code : Garden City, KS 67486	Board of Agriculture, Division of Water Resources Application Number:
--	--

3 LOCATE WELL'S LOCATION WITH AN "X" IN SECTION BOX:	4 DEPTH OF COMPLETED WELL ..... 40 ft. ELEVATION: ..... 2843.37 ft.
--	---

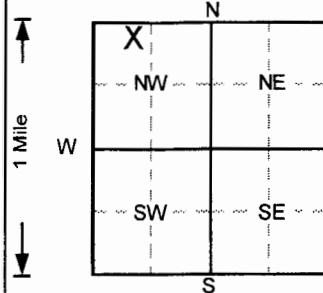

5 DEPTH OF COMPLETED WELL ..... 40 ft. ELEVATION: ..... 2843.37 ft.
Depth(s) Groundwater Encountered 1 ..... ft. 2 ..... ft. 3 ..... ft.
WELL'S STATIC WATER LEVEL ..... ft. below land surface measured on mo/day/yr ..... ft.
Pump test data: Well water was ..... NA ..... ft. after ..... hours pumping ..... gpm
Est. Yield ..... NA ..... gpm: Well water was ..... ft. after ..... hours pumping ..... gpm
Bore Hole Diameter ..... 8 in. to ..... 40 ft., and ..... in. to ..... ft.
WELL WATER TO BE USED AS: 5 Public water supply 8 Air conditioning 11 Injection well
1 Domestic 3 Feedlot 6 Oil field water supply 9 Dewatering
2 Irrigation 4 Industrial 7 Lawn and garden only 10 Monitoring well
Was a chemical/bacteriological sample submitted to Department? Yes ..... No ..... If yes, mo/day/yr sample was submitted
Water Well Disinfected? Yes ..... No ..... ✓

5 TYPE OF BLANK CASING USED:	5 Wrought iron 8 Concrete tile CASING JOINTS: Glued ..... Clamped ..... Welded ..... Threaded. ✓
1 Steel 3 RMP (SR) 6 Asbestos-Cement 9 Other (specify below)	7 PVC
2 PVC 4 ABS 7 Fiberglass	8 RMP (SR)

Blank casing diameter ..... 4 in. to ..... 10 ft., Dia ..... in. to ..... ft., Dia ..... in. to ..... ft.

Casing height above land surface ..... -4.68 in., weight ..... lbs./ft. Wall thickness or gauge No. ..... Sch. 40

TYPE OF SCREEN OR PERFORATION MATERIAL	7 PVC 10 Asbestos-cement
1 Steel 3 Stainless steel 5 Fiberglass 8 RMP (SR) 11 Other (specify)	2 Brass 4 Galvanized steel 6 Concrete tile 9 ABS 12 None used (open hole)

SCREEN OR PERFORATION OPENINGS ARE:	5 Gauzed wrapped 8 Saw cut 11 None (open hole)
1 Continuous slot 3 Mill slot 6 Wire wrapped 9 Drilled holes	2 Louvered shutter 4 Key punched 7 Torch cut 10 Other (specify)

SCREEN-PERFORATED INTERVALS: From ..... 10 ft. to ..... 40 ft., From ..... ft. to ..... ft.

From ..... ft. to ..... ft., From ..... ft. to ..... ft.

GRAVEL PACK INTERVALS: From ..... 8 ft. to ..... 40 ft., From ..... ft. to ..... ft.

From ..... ft. to ..... ft., From ..... ft. to ..... ft.

6 GROUT MATERIAL: 1 Neat cement 2 Cement grout 3 Bentonite 4 Other	10 Livestock pens 14 Abandoned water well
Grout Intervals: From ..... 3 ft. to ..... 8 ft., From ..... ft. to ..... ft., From ..... ft. to ..... ft.	11 Fuel storage 15 Oil well/Gas well
What is the nearest source of possible contamination:	12 Fertilizer storage 16 Other (specify below)
1 Septic tank 4 Lateral lines 7 Pit privy	13 Insecticide storage
2 Sewer lines 5 Cess pool 8 Sewage lagoon	How many feet?
3 Watertight sewer lines 6 Seepage pit 9 Feedyard	

Direction from well?

FROM	TO	LITHOLOGIC LOG	FROM	TO	PLUGGING INTERVALS
0	0.5	Concrete,			
0.5	3	Clay, silty, moist, no odor, Grayish Brown			
3	7	Clay, silty, moist, no odor, Brown			
7	11	Sand (vf-f), moist, no odor, Yellowish Brown			
11	17	Sand (f-c), silty, Brown to Yellowish Brown			
17	19	Silt, sandy, moist, no odor, Brown			
19	27	Sand (f-c) w/f-c gravel, moist, Grayish Brown			
27	35	Sand (f-c) w/occ. f-c gravel, Dark Gray			
35	40	Sand (f-c) w/f-c gravel, Gray			
					SVE1, Tag # 0042677, Flushmount
					Project Name: GF - Burtis Motor
					GeoCore # 1440, KDHE # U1 028 00189

7 CONTRACTOR'S OR LANDOWNER'S CERTIFICATION: This water well was (1) constructed, (2) reconstructed, or (3) plugged under my jurisdiction and was completed on (mo/day/year) ..... 7/25/2008 ..... and this record is true to the best of my knowledge and belief.

Kansas Water Well Contractor's License No. ..... 527 ..... This Water Well Record was completed on (mo/day/yr) ..... 8/22/2008 ..... under the business name of ..... GeoCore, Inc. ..... by (signature) ..... Dan Bell