

CORRECTION(S) TO WATER WELL RECORD (WWC-5)

(to rectify lacking or incorrect information)

County: Finney

Location listed as:

Section-Township-Range: None GivenFraction ($\frac{1}{4}$ $\frac{1}{4}$ $\frac{1}{4}$): _____

Location changed to:

9-24 S-32 WNW SW SW SW

Other changes: Initial statements: _____

Changed to: _____

Comments: _____

verification method: Well site address, city street map, other wells for same owner nearby, and mapping tool & aerial photos on KGS website. initials: DRK date: 10/1/2009

submitted by: Kansas Geological Survey, Data Resources Library, 1930 Constant Ave., Lawrence, KS 66047-3726

to: Kansas Dept of Health & Environment, Bureau of Water, 1000 SW Jackson, Suite 420, Topeka, KS 66612-1367.

m w 8

WATER WELL PLUGGING RECORD Form WWC-5P

KSA 82a-1212

ID NO.

0183767

1 LOCATION OF WATER WELL: County: Finney		Fraction $\frac{1}{4}$ $\frac{1}{4}$ $\frac{1}{4}$ $\frac{1}{4}$		Section Number		Township Number T S		Range Number ☐ E ☐ W	
Street/Rural Address of Well Location; if unknown, distance & direction from nearest town or intersection: If at owner's address, check here ☒ 1102 N. Campus Dr. Garden City, KS 67846				Global Positioning Systems (GPS) information: Latitude: _____ (in decimal degrees) Longitude: _____ (in decimal degrees) Elevation: _____ Datum: ☐ WGS84, ☐ NAD83, ☐ NAD27 Collection Method: ☐ GPS unit (Make/Model: _____) ☐ Digital Map/Photo, ☐ Topographic Map, ☐ Land Survey Est. Accuracy: ☐ < 3 m, ☐ 3-5 m, ☐ 5-15 m, ☐ > 15 m	
2 WATER WELL OWNER: Kwik Shop #701 RR#, St. Address, Box #: City, State ZIP Code:	
3 MARK WELL'S LOCATION WITH AN "X" IN SECTION BOX: 				4 DEPTH OF WELL 53.5 ft. WELL'S STATIC WATER LEVEL 0 ft WELL WAS USED AS: ☐ Domestic ☐ Irrigation ☐ Feedlot ☐ Industrial ☐ Public Water Supply ☐ Oil Field Water Supply ☐ Domestic (Lawn & Garden) ☐ Air Conditioning ☐ Dewatering ☒ Monitoring ☐ Injection Well ☐ Other _____ Was a chemical/bacteriological sample submitted to Department? Yes ☐ No ☐	
5 TYPE OF BLANK CASING USED: ☐ Steel ☒ PVC ☐ RMP (SR) ☐ ABS ☐ Wrought ☐ Asbestos-Cement ☐ Fiberglass ☐ Concrete Tile ☐ Other (Specify below) _____ Blank casing diameter 2 in. Was casing pulled? Yes ☒ No ☐ If yes, how much 10 ft. Casing height above or below land surface in.	
6 GROUT PLUG MATERIAL: ☐ Neat cement ☐ Cement grout ☒ Bentonite ☐ Other _____ Grout Plug Intervals: From 0 ft. to 53.5 ft., From _____ ft. to _____ ft., From _____ to _____ ft. What is the nearest source of possible contamination: ☐ Septic tank ☐ Sewer lines ☐ Watertight sewer lines ☐ Lateral lines ☐ Cess pool ☐ Seepage pit ☐ Pit privy ☐ Sewage lagoon ☐ Feedyard ☐ Livestock pens ☐ Fuel Storage ☐ Fertilizer storage ☐ Insecticide storage ☐ Abandoned water well ☐ Oil well/Gas well ☐ Other (specify below) _____ Direction from well? _____ How many feet? _____	
<table border="1" style="width:100%; border-collapse: collapse;"> <thead> <tr> <th>FROM</th> <th>TO</th> <th>PLUGGING MATERIALS</th> <th>FROM</th> <th>TO</th> <th>PLUGGING MATERIALS</th> </tr> </thead> <tbody> <tr> <td>0</td> <td>53.5</td> <td>Bentonite hole plug</td> <td></td> <td></td> <td></td> </tr> <tr><td> </td><td> </td><td> </td><td> </td><td> </td><td> </td></tr> <tr><td> </td><td> </td><td> </td><td> </td><td> </td><td> </td></tr> <tr><td> </td><td> </td><td> </td><td> </td><td> </td><td> </td></tr> <tr><td> </td><td> </td><td> </td><td> </td><td> </td><td> </td></tr> <tr><td> </td><td> </td><td> </td><td> </td><td> </td><td> </td></tr> <tr><td> </td><td> </td><td> </td><td> </td><td> </td><td> </td></tr> <tr><td> </td><td> </td><td> </td><td> </td><td> </td><td> </td></tr> </tbody> </table>										FROM	TO	PLUGGING MATERIALS	FROM	TO	PLUGGING MATERIALS	0	53.5	Bentonite hole plug	
FROM	TO	PLUGGING MATERIALS	FROM	TO	PLUGGING MATERIALS	
0	53.5	Bentonite hole plug	
7 CONTRACTOR'S OR LANDOWNER'S CERTIFICATION: This water well was plugged under my jurisdiction and was completed on (mo/day/year) 6/18/2009 and this record is true to the best of my knowledge and belief. Kansas Water Well Contractor's License No. 728. This Water Well Record was completed on (mo/day/year) 06/30/2009 under the business name of JC Drilling by (signature)	
INSTRUCTIONS: Use typewriter or ballpoint pen. Please press firmly and print clearly. Please fill in blanks, underline or circle the correct answers. Send top three copies to Kansas Department of Health and Environment, Bureau of Water, Geology Section, 1000 SW Jackson St., Ste. 420, Topeka, Kansas 66612-1367. Telephone: 785/296-5524. Send one to Water Well Owner and retain one for your records. Visit us at http://www.kdheks.gov/waterwell/index.html .	

Check one:



White Copy



Blue Copy



Pink Copy

0183083

MW 7 56' Det

MW 1 65' 0183337
Det

MW 8 53.5 0183767
Det

MW 9 56' 0183082
Det

Surrounding commercial properties

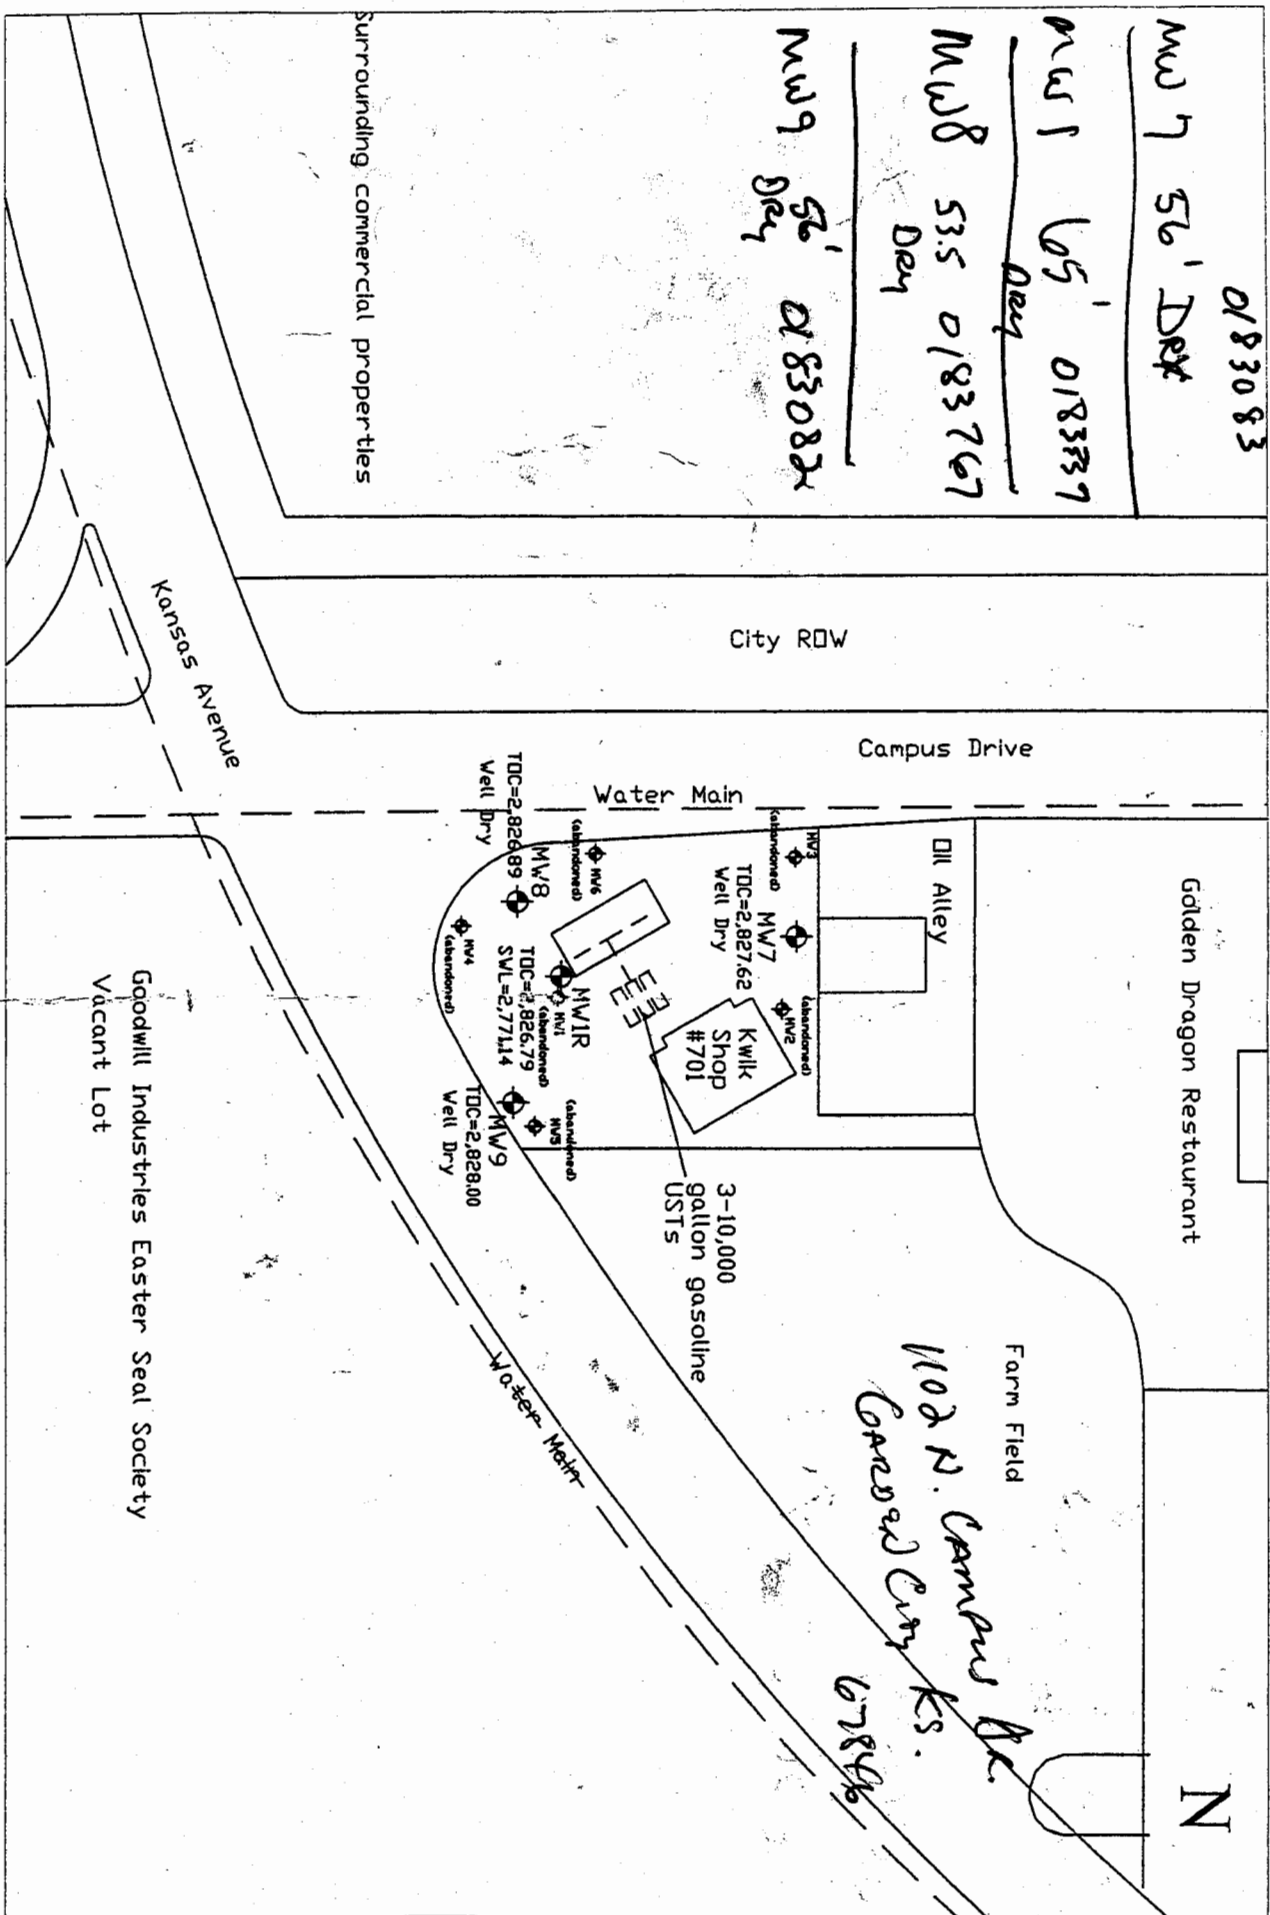


Figure 1

Groundwater Flow Map (12/17/08)

Site: Kwik Shop #701

Location: Garden City, KS

Date: 01/05/08 By: KLS

Legend

- Monitoring Well Location
- Soil Boring Location

Scale 1" = 100'



Engineering • Environmental • Construction
Grimes, IA St. Louis, MO Chicago, IL