

1 LOCATION OF WATER WELL: Fraction $\frac{1}{4}$ $\frac{1}{4}$ SW $\frac{1}{4}$ Section Number 19 Township Number T 24 S Range Number R 32 E/W

Distance and direction from nearest town or city street address of well if located within city?

302 Burnside Dr.

2 WATER WELL OWNER:

RR#, St. Address, Box # :

City, State, ZIP Code :

Randy Brangardt


302 Burnside Dr.

Hardey City, Mo. 67846

Board of Agriculture, Division of Water Resources

Application Number:

3 LOCATE WELL'S LOCATION WITH AN "X" IN SECTION BOX:

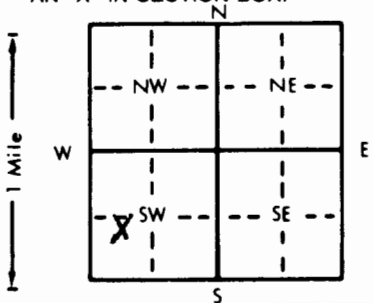

4 DEPTH OF COMPLETED WELL 257 ft. ELEVATION:

Depth(s) Groundwater Encountered 1. ft. 2. ft. 3. ft.

WELL'S STATIC WATER LEVEL 80 ft. below land surface measured on mo/day/yr 6-24-09

Pump test data: Well water was ft. after hours pumping gpm

Est. Yield gpm: Well water was ft. after hours pumping gpm

Bore Hole Diameter 10 in. to 260 ft. and in. to ft.

WELL WATER TO BE USED AS: 5 Public water supply 8 Air conditioning 11 Injection well

1 Domestic 3 Feedlot 6 Oil field water supply 9 Dewatering 12 Other (Specify below)

2 Irrigation 4 Industrial 7 Lawn and garden only 10 Monitoring well

Was a chemical/bacteriological sample submitted to Department? Yes No X; If yes, mo/day/yr sample was submitted

Water Well Disinfected? Yes X No

5 TYPE OF BLANK CASING USED:

5 Wrought iron

8 Concrete tile

CASING JOINTS: Glued X Clamped

1 Steel

3 RMP (SR)

6 Asbestos-Cement

9 Other (specify below)

Welded

2 PVC

4 ABS

7 Fiberglass

Threaded

Blank casing diameter 5 in. to 237 ft. Dia in. to ft. Dia in. to ft.

Casing height above land surface 18 in. weight 200 lbs./ft. Wall thickness or gauge No.

TYPE OF SCREEN OR PERFORATION MATERIAL:

1 Steel

3 Stainless steel

5 Fiberglass

8 RMP (SR)

11 Other (specify)

2 Brass

4 Galvanized steel

6 Concrete tile

9 ABS

12 None used (open hole)

SCREEN OR PERFORATION OPENINGS ARE:

1 Continuous slot

3 Mill slot

5 Gauzed wrapped

8 Saw cut

11 None (open hole)

2 Louvered shutter

4 Key punched

6 Wire wrapped

9 Drilled holes

7 Torch cut

10 Other (specify)

SCREEN-PERFORATED INTERVALS: From 237 ft. to 257 ft. From ft. to ft.

From ft. to ft. From ft. to ft.

GRAVEL PACK INTERVALS: From 230 ft. to 257 ft. From ft. to ft.

From 230 ft. to 257 ft. From ft. to ft.

6 GROUT MATERIAL:

1 Neat cement

2 Cement grout

3 Bentonite

4 Other

Grout Intervals: From 4 ft. to 30 ft. From 210 ft. to 230 ft. From ft. to ft.

What is the nearest source of possible contamination:

1 Septic tank

4 Lateral lines

7 Pit privy

10 Livestock pens

14 Abandoned water well

2 Sewer lines

5 Cess pool

8 Sewage lagoon

11 Fuel storage

15 Oil well/Gas well

3 Watertight sewer lines

6 Seepage pit

9 Feedyard

12 Fertilizer storage

16 Other (specify below)

13 Insecticide storage

Direction from well?

West

How many feet? 50 ft.

FROM	TO	LITHOLOGIC LOG	FROM	TO	PLUGGING INTERVALS
0	15	Fire Sand	172	180	Brown Sandy clay
15	60	Brown Sandy clay	180	192	Fire & med Sand & gravel
60	89	Fire & med Sand & gravel	192	200	Brown Sandy clay
89	92	Brown Sandy clay	200	230	Brown Sandy clay - fire Sand
92	100	Fire & med Sand & gravel			Hard str.
100	104	Hard Rock			
104	116	Fire & med Sand & gravel	230	255	Fire & med Sand & gravel
116	120	Hard Rock			
120	125	Brown Sandy clay			
125	129	Fire & med Sand & gravel	255	260	Brown Sandy clay
129	135	Hard Rock			
135	145	Brown Sandy clay			
145	149	Fire & med Sand & gravel			
149	156	Brown clay			
156	172	Fire & med Sand & gravel			

7 CONTRACTOR'S OR LANDOWNER'S CERTIFICATION: This water well was (1) constructed, (2) reconstructed, or (3) plugged under my jurisdiction and was completed on (mo/day/year) 6-24-09 and this record is true to the best of my knowledge and belief. Kansas

Water Well Contractor's License No. 172 This Water Well Record was completed on (mo/day/yr) 6-1-10

under the business name of Jonayon Water Well Service by (signature) reg