WATER WELL PLUGGING RECORD Form WWC-5P KSA 82a-1212 ID NO. AS-10

1 LOCATION OF WATER WELL:	Fraction	Section Number	Township Number	Range Number
Finney County	SE ¼ SE ¼ SE ¼	7	24 S	R 32 W

Distance and direction from nearest town or city street address of well if located within city?
Well was located at 407 E. Kansas, Garden City, KS

2 WATER WELL OWNER:
Rupp's Tire Service
RR#, St. Address, Box #:
407 E. Kansas Ave.
City, State ZIP Code:
Garden City, KS 67846

Global Positioning Systems (decimal degrees, min. of 4 digits
Latitude: _____
Longitude: _____
Elevation: _____
Datum: _____
Data Collection Method:

3 MARK WELL'S LOCATION WITH AN "X" IN SECTION BOX:

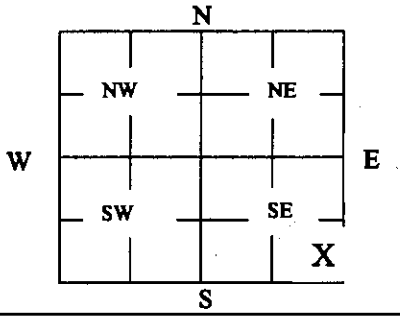

4 DEPTH OF WELL _____50_____ ft.

WELL'S STATIC WATER LEVEL_____38_____ft

WELL WAS USED AS: X

1 Domestic 5 Public Water Supply 9 Dewatering
2 Irrigation 6 Oil Field Water Supply 10 Monitoring
3 Feedlot 7 Domestic (Lawn & Garden) 11 Injection Well
4 Industrial 8 Air Conditioning 12 Other _____

Was a chemical/bacteriological sample submitted to Department? Yes_____ No _x____

5 TYPE OF BLANK CASING USED:
1 Steel 3 RMP (SR) 5 Wrought 7 Fiberglass 9 Other (Specify below)
2 PVC 4 ABS 6 Asbestos-Cement 8 Concrete Tile _____

Blank casing diameter __2____ in. Was casing pulled? Yes ___x___ No _____ If yes, how much _____50'_____
Casing height above or below land surface _____ in.

6 GROUT PLUG MATERIAL: 1 Neat cement 2 Cement grout 3 Bentonite 4 Other _ Soil_____

Grout Plug Intervals: From3 _0__ ft. to __50__ ft., From _____ ft. to _____ft., From _____ to _____ ft.

What is the nearest source of possible contamination:
1 Septic tank 6 Seepage pit 11 Fuel Storage 16 Other (specify below)
2 Sewer lines 7 Pit privy 12 Fertilizer storage _Contaminated Site_____
3 Watertight sewer lines 8 Sewage lagoon 13 Insecticide storage
4 Lateral lines 9 Feedyard 14 Abandoned water well Direction from well? _____
5 Cess pool 10 Livestock pens 15 Oil well/Gas well How many feet? _____

FROM	TO	PLUGGING MATERIALS	FROM	TO	PLUGGING MATERIALS
0'	50'	Hydrated Bentonite Chips			
		Well drilled out to TD and plugged with Bentonite per KDHE project manager			

7 CONTRACTOR'S OR LANDOWNER'S CERTIFICATION: This water well was plugged under my jurisdiction and was completed on (mo/day/year) ___09/11/12_____ and this record is true to the best of my knowledge and belief. Kansas Water Well Contractor's License No. ___585_____. This Water Well Record was completed on (mo/day/year) ___09/26/12___ under the business name of Associated Environmental, Inc. by (signature) _____.

INSTRUCTIONS: Use typewriter or ballpoint pen. Please press firmly and print clearly. Please fill in blanks, underline or circle the correct answers. Send top three copies to Kansas Department of Health and Environment, Bureau of Water, Geology Section, 1000 SW Jackson St., Ste. 420, Topeka, Kansas 66612-1367. Telephone: 785/296-5522. Send one to Water Well Owner and retain one for your records. Visit us at http://www.kdheks.gov/waterwell/index.html.