

1 LOCATION OF WATER WELL:	Fraction	Section Number	Township Number	Range Number
County: <b>Finney</b>	<b>NW 1/4 NW 1/4 NW 1/4</b>	<b>18</b>	<b>T 24 S</b>	<b>R 32 W</b>

Distance and direction from nearest town or city street address of well if located within city?

North of 705 Buffalo Jones Ave., Garden City, KS


2 WATER WELL OWNER: **KDHE**RR#, St. Address, Box #: **1000 SW Jackson; Ste. 410**

Board of Agriculture, Division of Water Resources

City, State, ZIP Code: **Topeka, KS 66612**

Application Number:

## 3 LOCATE WELL'S LOCATOR WITH AN "X" IN SECTION BOX:

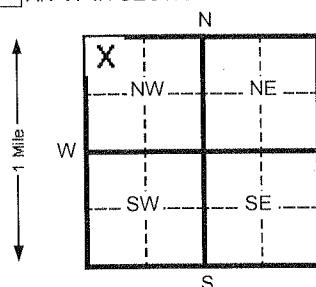

## 4 DEPTH OF COMPLETED WELL

25 ft. ELEVATION:

**2756.40**

Depth(s) Groundwater Encountered 1.5 ft. 2 ft. 3 ft. Ft.

WELL'S STATIC WATER LEVEL ft. below land surface measured on mo/day/yr

Pump test data: Well water was Ft. after hours pumping Gpm

Est. Yield Gpm: Well water was Ft. after Hours pumping Gpm

Bore Hole Diameter 10.5 in. to 25 ft. and in. to Ft.

WELL WATER TO BE USED AS: 5 Public water supply 8 Air conditioning 11 Injection well

1 Domestic 3 Feed lot 6 Oil field water supply 9 Dewatering 12 Other (Specify below)

2 Irrigation 4 Industrial 7 Lawn and garden (domestic) 10 Monitoring well **SVE-3**Was a chemical/bacteriological sample submitted to Department? Yes No  If yes, mo/day/yr sample wasSubmitted Water Well Disinfected? Yes No 

## 5 TYPE OF BLANK CASING USED:

1 Steel	3 RMP (SR)
2 PVC	4 ABS

5 Wrought Iron

6 Asbestos-Cement

7 Fiberglass

8 Concrete tile

9 Other (specify below)

CASING JOINTS: Glued

Clamped

Welded

Threaded 

Blank casing diameter 4 in. to 10 in. to Dia ft. Dia in. to ft.

Casing height above land surface FLUSH in., weight SCH 40 Lbs./ft. Wall thickness or gauge No.

TYPE OF SCREEN OR PERFORATION MATERIAL:

7 PVC 10 Asbestos-cement

1 Steel	3 Stainless steel	5 Fiberglass	8 RMP (SR)	11 Other (specify)
2 Brass	4 Galvanized steel	6 Concrete tile	9 ABS	12 None used (open hole)

SCREEN OR PERFORATION OPENINGS ARE:

8 Saw cut 11 None (open hole)

1 Continuous slot	3 Mill slot	6 Wire wrapped	9 Drilled holes
2 Louvered shutter	4 Key punched	7 Torch cut	10 Other (specify)

SCREEN-PERFORATED INTERVALS: From 10 ft. to 25 ft. From ft. to ft. From ft. to ft. From ft. to ft.

SAND PACK INTERVALS: From 8 ft. to 25 ft. From ft. to ft. From ft. to ft. From ft. to ft.

6 GROUT MATERIAL: 1 Neat cement 2 Cement grout 3 Bentonite 4 Other

Grout Intervals From 2 0.5 ft. to 4 Ft. From 3 4 to 8 Ft. From ft. to ft.

What is the nearest source of possible contamination:

10 Livestock pens 14 Abandoned water well

1 Septic tank	4 Lateral lines	7 Pit privy	11 Fuel storage
2 Sewer lines	5 Cess pool	8 Sewage lagoon	12 Fertilizer storage
3 Watertight sewer lines	6 Seepage pit	9 Feedyard	13 Insecticide storage

15 Oil well/ Gas well

16 Other (specify below)

**Contaminated Site**

Direction from well?

How many feet?

FROM TO CODE LITHOLOGIC LOG FROM TO PLUGGING INTERVALS

0 0.5 1" Asphalt/5" Concrete

0.5 5 Silty Clay

5 25 Sand

25 TD End of Borehole

## 7 CONTRACTOR'S OR LANDOWNER'S CERTIFICATION: This water well was (x) constructed, (2) reconstructed, or (3) plugged under my jurisdiction and w

Completed on (mo/day/yr) **02/19/13** And this record is true to the best of my knowledge and belief. KansasWater Well Contractor's License No. **585** This Water Well Record was completed on (mo/day/yr) **06/18/13**under the business name of **Associated Environmental, Inc.** By (signature) **Bradley J. Johnson**

INSTRUCTIONS: Please fill in blanks and circle the correct answers. Send three copies to Kansas Department of Health and Environment, Bureau of Water, Topeka, Kansas 66620-0001. Telephone: 913-296-5545. Send one to WATER WELL OWNER and retain one for your records.