

1 LOCATION OF WATER WELL: County: Finney	Fraction NW ¼ SW ¼ SW ¼	Section Number 16	Township Number T 24 S	Range Number R 32 EW
--	-----------------------------------	-----------------------------	----------------------------------	--------------------------------

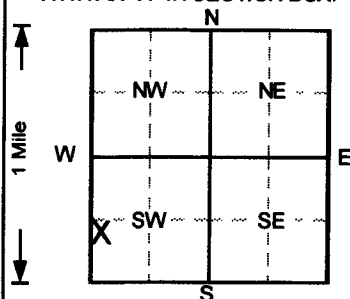
Distance and direction from nearest town or city street address of well if located within city?

156 N Campus Dr, Garden City2 WATER WELL OWNER: **U Pump It Kansas, Inc.**RR#, St. Address, Box # : **504 E Fulton St #B**City, State, ZIP Code : **Garden City, Kansas 67846**

Board of Agriculture, Division of Water Resources

Application Number:

3 LOCATE WELL'S LOCATION WITH AN "X" IN SECTION BOX:

4 DEPTH OF COMPLETED WELL: **120** ft. ELEVATION: **2825.52**

Depth(s) Groundwater Encountered 1. ft. 2. ft. 3. ft.

WELL'S STATIC WATER LEVEL **75.02** ft. below land surface measured on mo/day/yr **11/20/2015**Pump test data: Well water was **NA** ft. after hours pumping gpmEst. Yield **NA** gpm: Well water was ft. after hours pumping gpmBore Hole Diameter **8.5** in. to **123** ft. and in. to ft.

WELL WATER TO BE USED AS: 5 Public water supply 8 Air conditioning 11 Injection well

1 Domestic 3 Feedlot 6 Oil field water supply 9 Dewatering 12 Other (Specify below)

2 Irrigation 4 Industrial 7 Lawn and garden only **10 Monitoring well**Was a chemical/bacteriological sample submitted to Department? Yes No ☒; If yes, mo/day/yr sample was submittedWater Well Disinfection? Yes No ☒

5 TYPE OF BLANK CASING USED:

1 Steel

3 RMP (SR)

5 Wrought iron

8 Concrete tile

CASING JOINTS: Glued Clamped

2 PVC

4 ABS

6 Asbestos-Cement

9 Other (specify below)

Welded

Blank casing diameter **4** in. to **55** ft. Dia. in. to ft. Dia. in. to ft.Casing height above land surface **-4.2** in., weight lbs./ft. Wall thickness or gauge No. **Sch. 80**

TYPE OF SCREEN OR PERFORATION MATERIAL

1 Steel

3 Stainless steel

5 Fiberglass

7 PVC

10 Asbestos-cement

2 Brass

4 Galvanized steel

6 Concrete tile

8 RMP (SR)

11 Other (specify)

SCREEN OR PERFORATION OPENINGS ARE:

1 Continuous slot

3 Mill slot

5 Gauzed wrapped

8 Saw cut

11 None (open hole)

2 Louvered shutter

4 Key punched

6 Wire wrapped

9 Drilled holes

SCREEN-PERFORATED INTERVALS: From **55** ft. to **120** ft. From ft. to ft.

From ft. to ft. From ft. to ft.

GRAVEL PACK INTERVALS: From **51** ft. to **123** ft. From ft. to ft.

From ft. to ft. From ft. to ft.

6 GROUT MATERIAL:

1 Neat cement

2 Cement grout

3 Bentonite**4 Other Concrete**Grout intervals: From **0** ft. to **2** ft. From **2** ft. to **51** ft. From ft. to ft.

What is the nearest source of possible contamination:

1 Septic tank

4 Lateral lines

7 Pit privy

10 Livestock pens

14 Abandoned water well

2 Sewer lines

5 Cess pool

8 Sewage lagoon

11 Fuel storage

15 Oil well/Gas well

3 Watertight sewer lines

6 Seepage pit

9 Feedyard

12 Fertilizer storage

16 Other (specify below)

13 Insecticide storage

Direction from well?

How many feet?

FROM	TO	LITHOLOGIC LOG	FROM	TO	PLUGGING INTERVALS
0	0.5	Concrete,			
0.5	5	Clay, silty, Lt. Brown			
5	23	Sand, vf-c,			
23	33	Sand, vf-f gravel,			
33	42	Sand, vf-c and gravel, f-m,			
42	50	Clay, sandy w/sand stringers, Lt. Gray			
50	58	Clay, sandy w/sand stringers, Lt. Brown			
58	66	Sandstone, Lt. Gray			
66	73	Sand w/gravel, caliche stringers,			
73	80	Clay, sandy w/occ. gravel, Lt. Brown			
80	102	Sand, vf-c gravel w/occ f gravel,			
102	110	Clay, sandy w/sand stringers, Lt. Gray			
110	123	Clay, sandy w/sand lenses, Lt. Brown			
					MW25, Flushmount
					Project Name: GF - U-Pump-It #207
					GeoCore # 1880, KDHE # U1 028 14370

7 CONTRACTOR'S OR LANDOWNER'S CERTIFICATION: This water well was **(1)** constructed, (2) reconstructed, or (3) plugged under my jurisdiction and was completed on (mo/day/year) **11/19/2015** and this record is true to the best of my knowledge and belief.

Kansas Water Well Contractor's License No. **527**. This Water Well Record was completed on (mo/day/yr) **12/14/2015** under the business name of **GeoCore, Inc.** by (signature) *[Signature]*