

WATER WELL PLUGGING RECORD Form WWC-5P KSA 82a-1212 ID NO.


MW18

1 LOCATION OF WATER WELL: County: Finney Fraction NW 1/4 SE 1/4 SE 1/4 SE 1/4 Section Number 7 Township Number T 24 S Range Number 32 E X W

Street/Rural Address of Well Location; if unknown, distance & direction from nearest town or intersection: If at owner's address, check here -200' N of 407 E Kansas Ave., Garden City, KS

Global Positioning Systems (GPS) information: Latitude: 37.97596 (in decimal degrees) Longitude: 100.87631 (in decimal degrees) Elevation: NA Horizontal Datum WGS84, X NAD83, NAD27 Collection Method: GPS unit (Make/model): Digital Map/Photo, Topographic Map, Land Survey Est. Accuracy: <3 m, 3-5 m, 5-15 m, >15 m

2 WATER WELL OWNER: Rupp's Tire Service RR#, St. Address, Box #: 407 E Kansas Ave. City, State ZIP Code: Garden City, KS 67846

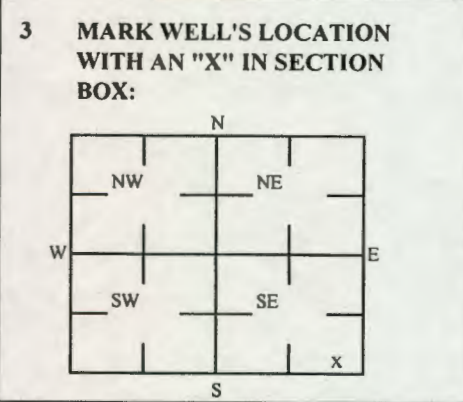

3 MARK WELL'S LOCATION WITH AN "X" IN SECTION BOX: 4 DEPTH OF WELL 43.9 ft. WELL'S STATIC WATER LEVEL NA ft. WELL WAS USED AS: Domestic, Irrigation, Feedlot, Industrial, Public Water Supply, Oil Field Water Supply, Domestic (Lawn & Garden), Air Conditioning, Dewatering, Monitoring, Injection Well, Other. Was a chemical/bacteriological sample submitted to Department? Yes No X

5 TYPE OF BLANK CASING USED: Steel, PVC, RMP (SR), ABS, Wrought, Asbestos-Cement, Fiberglass, Concrete Tile, Other (Specific below). Blank casing diameter 2 in. Was casing pulled? Yes X No. If yes, how much 3'. Casing height above or below land surface NA in.

6 GROUT PLUG MATERIAL: Neat cement, Cement grout, X Bentonite, X Other Soil: 0-3'. Grout Plug Intervals: From 3 ft to 43.9 ft, From ft to ft, From ft to ft. What is the nearest source of possible contamination: Septic tank, Sewer lines, Watertight sewer lines, Lateral lines, Cess pool, Seepage pit, Pit privy, Sewage lagoon, Feed yard, Livestock pens, Fuel storage, Fertilizer storage, Insecticide storage, Abandoned water well, Oil well/Gas well, Other (specify below). Direction from well? How many feet?

Table with columns FROM, TO, PLUGGING MATERIALS. Row 1: 0, 3, Soil. Row 2: 3, 43.9, Bentonite. Includes KDHE ID: Rupp's Tire Service; U1-028-13828

7 CONTRACTOR'S OR LANDOWNER'S CERTIFICATION: This water well was plugged under my jurisdiction and was completed on (mo/day/year) 8/22-24/22 and this record is true to the best of my knowledge and belief. Kansas Water Contractor's License No. 757. This Water Well Record was completed on (mo/day/year) 8/26/2022 under the business name of Larsen & Associates, Inc. By (signature)

Send one white copy to Kansas Department of Health & Environment, Geology Section, 1000 SW Jackson Street, Ste. 420, Topeka, KS 66612-1367. Send one copy to WATER WELL OWNER and retain one for your records. Visit us at http://www.kdheks.gov/waterwell/index.html Telephone 785-296-5524.