

County: Finney Fraction: NW NW NW Sec. 18 T. 24 S R. 32 W

CORRECTION(S) to WATER WELL COMPLETION RECORD Form WWC-5 (to rectify lacking or incorrect information)

Owner: Kustom Auto Radio KMW 1

If location corrected, was listed as:

Section-Township-Range: 18-24-33W

Location changed to:

18-24-32W

Fraction (¼ calls): _____

Other changes: Initial statements: _____

Changed to: _____

Comments: Error reported by Mapper user.

Address of owner in Garden City places well in Range 32 W, not Range 33 W.

Verification method: Address of owner confirmed on business' website. Location description on some wells in this monitoring series matches owner location in Garden City, using KGS Interactive Map.

Initials: SH Date: 8/20/2019

Submitted by: ☒ Kansas Geological Survey, Data Resources Library, 1930 Constant Ave., Lawrence, KS 66047-3724
☐ Kansas Dept. of Health & Environment, Bureau of Water, 1000 SW Jackson, Suite 420, Topeka, KS 66612-1367


1 LOCATION OF WATER WELL:	Fraction	Section Number	Township Number	Range Number
County: Finney	NW₄ NW ₁/₄ NW₁/₄	18	T 24 S	R 33 E (W)

Distance and direction from nearest town or city street address of well if located within city?

On Kustom Auto Radio lot

2. WATER WELL OWNER:		Kustom Auto Radio	
RR#, St. Address, Box # :		P.O. Box 571	Board of Agriculture, Division of Water Resources
City, State, ZIP Code :		Garden City, Ks.	Application Number:

3] LOCATE WELL'S LOCATION WITH AN "X" IN SECTION BOX: 4 DEPTH OF COMPLETED WELL... 33 ft. ELEVATION: NA

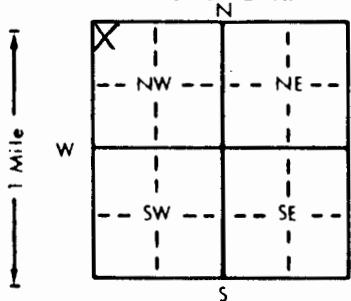

4. DEPTH OF COMPLETED WELL... 33... ft. ELEVATION: NA
Depth(s) Groundwater Encountered 1. 23... ft. 2. ... ft. 3. ... ft.
WELL'S STATIC WATER LEVEL ... 23.91... ft. below land surface measured on mo/day/yr 11-19-93
Pump test data: Well water was ... ft. after ... hours pumping ... gpm
Est. Yield ... gpm: Well water was ... ft. after ... hours pumping ... gpm
Bore Hole Diameter 7 5/8 ... in. to ... 33 ... ft., and ... in. to ... ft.
WELL WATER TO BE USED AS: 5 Public water supply 8 Air conditioning 11 Injection well
1 Domestic 3 Feedlot 6 Oil field water supply 9 Dewatering 12 Other (Specify below)
2 Irrigation 4 Industrial 7 Lawn and garden only 10 Monitoring well
Was a chemical/bacteriological sample submitted to Department? Yes... No X; If yes, mo/day/yr sample was submitted
Water Well Disinfected? Yes No X

5 TYPE OF BLANK CASING USED:		5 Wrought iron	8 Concrete tile	CASING JOINTS: Glued Clamped
1 Steel	3 RMP (SR)	6 Asbestos-Cement	9 Other (specify below)	Welded
2 PVC	4 ABS	7 Fiberglass		Threaded. <input checked="" type="checkbox"/>

Blank casing diameter 2 in. to 18 ft. Dia in. to ft. Dia in. to ft.
Casing height above land surface 0 in. weight lbs./ft. Wall thickness or gauge No. sch. 40

TYPE OF SCREEN OR PERFORATION MATERIAL:

1 Steel	3 Stainless steel	5 Fiberglass	7 PVC	10 Asbestos-cement
2 Brass	4 Galvanized steel	6 Concrete tile	8 RMP (SR)	11 Other (specify)
			9 ABS	12 None used (open hole)

SCREEN OR PERFORATION OPENINGS ARE:

1 Continuous slot	3 Mill slot	5 Gauzed wrapped	8 Saw cut	11 None (open hole)
2 Louvered shutter	4 Key punched	6 Wire wrapped	9 Drilled holes	
		7 Torch cut	10 Other (specify)	

SCREEN-PERFORATED INTERVALS: From 18 ft. to 33 ft., From ft. to ft.
From ft. to ft., From ft. to ft.
GRAVEL PACK INTERVALS: From 16 ft. to 33 ft., From ft. to ft.
From ft. to ft., From ft. to ft.

6 GROUT MATERIAL: 1 Neat cement 2 Cement grout 3 Bentonite 4 Other

Grout Intervals: From 0 ft. to 14 ft. From 14 ft. to 16 ft. From ft. to ft.

What is the nearest source of possible contamination:

1 Septic tank	4 Lateral lines	7 Pit privy	10 Livestock pens	14 Abandoned water well
2 Sewer lines	5 Cess pool	8 Sewage lagoon	11 Fuel storage	15 Oil well/Gas well
3 Watertight sewer lines	6 Seepage pit	9 Feedyard	12 Fertilizer storage	16 Other (specify below)

Direction from well? **southeast**

How many feet? **60'**

FROM	TO	LITHOLOGIC LOG	FROM	TO	PLUGGING INTERVALS
0	6"	concrete			
6"	1'	cly, v dk brn, v slty, sl to v f to med snd			
1	6	cly, lt red brn, v f snd			
6	10	snd, v f to f grn, orange-brn, v slty, sl clyey			
10	17	snd, v f to f grn, yell-brn, v slty, sl clyey			
17	33	snd, f to c, mod rock & grvl, prly srted, ang-rnd, yell-brn			
					KMW1-flush mount cover

7] CONTRACTOR'S OR LANDOWNER'S CERTIFICATION: This water well was (1) constructed, (2) reconstructed, or (3) plugged under my jurisdiction and was completed on (mo/day/year) . . . 11-06-93 and this record is true to the best of my knowledge and belief. Kansas Water Well Contractor's License No. . . . 527 This Water Well Record was completed on (mo/day/yr) 12-09-93 under the business name of **GeoCore Services, Inc.** by (signature) *Dale Robb*