

County: Finney Fraction: NW NW NW Sec. 18 T. 24 S R. 32 W

CORRECTION(S) to WATER WELL COMPLETION RECORD Form WWC-5 (to rectify lacking or incorrect information)

Owner: Kustom Auto Radio KMW 4

If location corrected, was listed as:

Section-Township-Range: 18-24-33W

Location changed to:

18-24-32W

Fraction (1/4 calls): _____

Other changes: Initial statements: _____

Changed to: _____

Comments: Error reported by Mapper user.

Address of owner in Garden City places well in Range 32 W, not Range 33 W.

Verification method: Address of owner confirmed on business' website. Location description on some wells in this monitoring series matches owner location in Garden City, using KGS Interactive Map.

Initials: SH Date: 8/20/2019

Submitted by: ☒ Kansas Geological Survey, Data Resources Library, 1930 Constant Ave., Lawrence, KS 66047-3724
☐ Kansas Dept. of Health & Environment, Bureau of Water, 1000 SW Jackson, Suite 420, Topeka, KS 66612-1367


1 LOCATION OF WATER WELL:	Fraction	Section Number	Township Number	Range Number
County: Finney	NW NW ¼ NW	18	T 24 S	R 33 E

Distance and direction from nearest town or city street address of well if located within city?

On Kustom Auto Radio lot

2	WATER WELL OWNER:	Kustom Auto Radio	
	RR#, St. Address, Box # :	P.O. Box 571	Board of Agriculture, Division of Water Resources
	City, State, ZIP Code :	Garden City, Ks.	Application Number:

3] LOCATE WELL'S LOCATION WITH AN "X" IN SECTION BOX: 4] DEPTH OF COMPLETED WELL: 33 ft. ELEVATION: NA

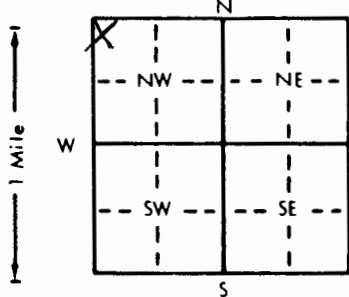

WELL'S STATIC WATER LEVEL 23.79 ft. below land surface measured on mo/day/yr 11-19-93

Pump test data: Well water was ft. after hours pumping gpm
 Est. Yield gpm: Well water was ft. after hours pumping gpm
 Bore Hole Diameter . 7 5/8 . in. to 33 ft., and in. to ft.

WELL WATER TO BE USED AS:

1 Domestic	3 Feedlot	6 Oil field water supply	9 Dewatering	12 Other (Specify below)
2 Irrigation	4 Industrial	7 Lawn and garden only	(10) Monitoring well	

Was a chemical/bacteriological sample submitted to Department? Yes..... No. X.....; If yes, mo/day/yr sample was submitted

Water Well Disinfected? Yes No X

5] TYPE OF BLANK CASING USED:		5 Wrought iron	8 Concrete tile	CASING JOINTS: Glued Clamped
1 Steel	3 RMP (SR)	6 Asbestos-Cement	9 Other (specify below)	Welded
(2) PVC	4 ABS	7 Fiberglass		Threaded. <input checked="" type="checkbox"/>

Blank casing diameter 2 . . . in. to . . . 18 . . . ft., Dia . . . in. to . . . ft., Dia . . . in. to . . . ft.
Casing height above land surface 0 . . . in., weight lbs./ft. Wall thickness or gauge No. . . sch. 40

TYPE OF SCREEN OR PERFORATION MATERIAL:

1 Steel	3 Stainless steel	5 Fiberglass	7 PVC	10 Asbestos-cement
2 Brass	4 Galvanized steel	6 Concrete tile	8 RMP (SR)	11 Other (specify)
			9 ABS	12 None used (open hole)

SCREEN OR PERFORATION OPENINGS ARE:

1 Continuous slot	3 Mill slot	5 Gauzed wrapped	8 Saw cut	11 None (open hole)
2 Louvered shutter	4 Key punched	6 Wire wrapped	9 Drilled holes	
		7 Torch cut	10 Other (specify)	

SCREEN-PERFORATED INTERVALS:	From 18 ft. to 33 ft.	From ft. to ft.
	From ft. to ft.	From ft. to ft.
GRAVEL PACK INTERVALS:	From 16 ft. to 33 ft.	From ft. to ft.
	From ft. to ft.	From ft. to ft.

6 GROUT MATERIAL: 1 Neat cement 2 Cement grout 3 Bentonite 4 Other
Grout Intervals: From 0 ft. to 14 ft. From 14 ft. to 16 ft. From ft. to ft.

What is the nearest source of possible contamination:

1 Septic tank	4 Lateral lines	7 Pit privy	10 Livestock pens	14 Abandoned water well
2 Sewer lines	5 Cess pool	8 Sewage lagoon	11 Fuel storage	15 Oil well/Gas well
3 Watertight sewer lines	6 Seepage pit	9 Feedyard	12 Fertilizer storage	16 Other (specify below)
			13 Insecticide storage

Direction from well? northwest How many feet? 70'

FROM	TO	LITHOLOGIC LOG
0	1	cly, v dk brn, v slty, v grvly
1	4	cly, lt yell-brn, v slty, v sndy, f-med grn, mod-v grvly
4	10	snd, lt yell-brn, v slty, v f-f grn, well srt'd
10	11	cly, lt red yell-brn cly, v slty & sndy, v f grn
11	15	snd, f-c grn, mod grvl, yell-brn, rnd-ang
15	16	snd, v f grn, yell-brn, sl clayey w/cly seam @ 16'
16	28	snd, f-c grn, mod grvl, lt-dk gry, prly srt'd
28	33	snd, f-c grn, lt-dk gry, mod rock up to 2" in size
		KMW4-flush mount cover

7] CONTRACTOR'S OR LANDOWNER'S CERTIFICATION: This water well was (1) constructed, (2) reconstructed, or (3) plugged under my jurisdiction and was completed on (mo/day/year) 11-08-93 and this record is true to the best of my knowledge and belief. Kansas Water Well Contractor's License No. 527 This Water Well Record was completed on (mo/day/yr) 12-09-93 under the business name of GeoCore Services, Inc. by (signature) [Signature]