

County: Finney Fraction: NW NW NW Sec. 18 T. 24 S R. 32 W

CORRECTION(S) to WATER WELL COMPLETION RECORD Form WWC-5 (to rectify lacking or incorrect information)

Owner: Kustom Auto Radio KMW 6

If location corrected, was listed as:

Section-Township-Range: 18-24-33W

Location changed to:

18-24-32W

Fraction (1/4 calls): _____

Other changes: Initial statements: _____

Changed to: _____

Comments: Error reported by Mapper user.

Address of owner in Garden City places well in Range 32 W, not Range 33 W.

Verification method: Address of owner confirmed on business' website. Location description on some wells in this monitoring series matches owner location in Garden City, using KGS Interactive Map.

Initials: SH Date: 8/20/2019

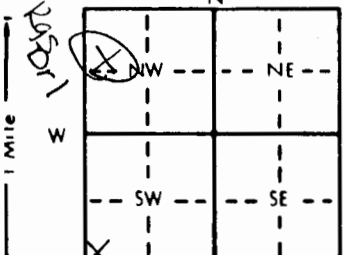
Submitted by: ☒ Kansas Geological Survey, Data Resources Library, 1930 Constant Ave., Lawrence, KS 66047-3724
☐ Kansas Dept. of Health & Environment, Bureau of Water, 1000 SW Jackson, Suite 420, Topeka, KS 66612-1367

LOCATION OF WATER WELL: County: Finney	Fraction NW₄ NW $\frac{1}{4}$ NW₄	Section Number 18	Township Number T 24 S	Range Number R 33 EW
--	--	-----------------------------	----------------------------------	--------------------------------

Distance and direction from nearest town or city street address of well if located within city?

80' north of Kustom Auto Radio lot, on north side of Kansas Avenue

WATER WELL OWNER: RR#, St. Address, Box # : City, State, ZIP Code	Kustom Auto Radio P.O. Box 571 Garden City, Ks.	Board of Agriculture, Division of Water Resources Application Number:
---	--	--

LOCATE WELL'S LOCATION WITH AN "X" IN SECTION BOX:	4 DEPTH OF COMPLETED WELL... 33 ft. ELEVATION: NA
	Depth(s) Groundwater Encountered 1. 23 ft. 2. ft. 3. ft.
	WELL'S STATIC WATER LEVEL... 23.32 ft. below land surface measured on mo/day/yr 11-19-93
	Pump test data: Well water was ft. after hours pumping gpm
	Est. Yield gpm: Well water was ft. after hours pumping gpm
	Bore Hole Diameter 7 5/8 in. to 33 ft., and in. to ft.
	WELL WATER TO BE USED AS: 5 Public water supply 8 Air conditioning 11 Injection well
	1 Domestic 3 Feedlot 6 Oil field water supply 9 Dewatering 12 Other (Specify below)
	2 Irrigation 4 Industrial 7 Lawn and garden only (10) Monitoring well
	Was a chemical/bacteriological sample submitted to Department? Yes No X ; If yes, mo/day/yr sample was submitted
	Water Well Disinfected? Yes No X

TYPE OF BLANK CASING USED:	5 Wrought iron 8 Concrete tile CASING JOINTS: Glued Clamped
1 Steel 3 RMP (SR) 6 Asbestos-Cement 9 Other (specify below) Welded	
(2) PVC 4 ABS 7 Fiberglass Threaded X	
Blank casing diameter 2 in. to 18 ft., Dia in. to ft., Dia in. to ft.	
Casing height above land surface 0 in., weight lbs./ft. Wall thickness or gauge No. sch. 40	
TYPE OF SCREEN OR PERFORATION MATERIAL:	(7) PVC 10 Asbestos-cement
1 Steel 3 Stainless steel 5 Fiberglass 8 RMP (SR) 11 Other (specify)	
2 Brass 4 Galvanized steel 6 Concrete tile 9 ABS 12 None used (open hole)	
SCREEN OR PERFORATION OPENINGS ARE:	5 Gauzed wrapped 8 Saw cut 11 None (open hole)
1 Continuous slot (3) Mill slot 6 Wire wrapped 9 Drilled holes	
2 Louvered shutter 4 Key punched 7 Torch cut 10 Other (specify)	
SCREEN-PERFORATED INTERVALS: From 18 ft. to 33 ft., From ft. to ft.	
GRAVEL PACK INTERVALS: From 16 ft. to 33 ft., From ft. to ft.	

GROUT MATERIAL:	1 Neat cement (2) Cement grout (3) Bentonite 4 Other
Grout Intervals: From 0 ft. to 14 ft., From 14 ft. to 16 ft., From ft. to ft.	
What is the nearest source of possible contamination:	10 Livestock pens 14 Abandoned water well
1 Septic tank 4 Lateral lines 7 Pit privy (11) Fuel storage 15 Oil well/Gas well	
2 Sewer lines 5 Cess pool 8 Sewage lagoon 12 Fertilizer storage 16 Other (specify below)	
3 Watertight sewer lines 6 Seepage pit 9 Feedyard 13 Insecticide storage	
Direction from well? southwest	How many feet? 100'

FROM	TO	LITHOLOGIC LOG	FROM	TO	PLUGGING INTERVALS
0	3"	cement			
3"	5'	cly, v dk brn, mod slty, mod snd, f-c grn			
5	6	cly, lt-med gry & tr of snd, f-c grn			
6	10	snd, v f grn, dk gry, rnd-subang			
10	15	snd, v f grn, lt gry, rnd-subang			
15	20	snd, f-c grn, mod grvl, tr of rock, poorly srted yell-brn color			
20	22	snd, f grn, tr of rock, well srted, yell-brn color			
22	28	snd, f-c grn, mod grvl, tr of rock, poorly srted, yell brn			
28	33	snd, f-c grn, mod grvl, mod rock up to 2" in size			
					KMW6-flush mount cover

CONTRACTOR'S OR LANDOWNER'S CERTIFICATION: This water well was (1) constructed, (2) reconstructed, or (3) plugged under my jurisdiction and was completed on (mo/day/year) 11-08-93 and this record is true to the best of my knowledge and belief. Kansas Water Well Contractor's License No. 527 This Water Well Record was completed on (mo/day/yr) 12-09-93 under the business name of GedCore Services, Inc. by (signature) <i>Don Roll</i>
