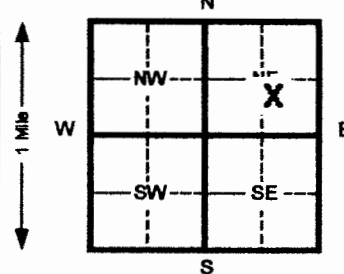


1 LOCATION OF WATER WELL: County: Finney		Fraction NW ¼ SE ¼ NE ¼	Section Number 22	Township Number T 24 S	Range Number R 33 E/W
Distance and direction from nearest town or city street address of well if located within city?					
2 WATER WELL OWNER: Charlie Owings					
RR#, St. Address, Box # : 2405 Jennie Baker Rd			Board of Agriculture, Division of Water Resources		
City, State, ZIP Code : Garden City Ks 67846			Application Number:		
3 LOCATE WELL'S LOCATION WITH AN "X" IN SECTION BOX:		4 DEPTH OF COMPLETED WELL 345 ft. ELEVATION:			
		Depth(s) Groundwater Encountered 1 45 ft. 2 _____ ft. 3 _____ ft. WELL'S STATIC WATER LEVEL 150 ft. below land surface measured on mo/day/yr 1/18/05 Pump test data: Well water was _____ ft. after _____ hours pumping _____ gpm Est. Yield _____ gpm: Well water was _____ ft. after _____ hours pumping _____ gpm Bore Hole Diameter 10 in. to _____ ft. and _____ in. to _____ ft. WELL WATER TO BE USED AS: 5 Public water supply 8 Air conditioning 11 Injection well 1 Domestic 3 Feed lot 6 Oil field water supply 9 Dewatering 12 Other (Specify below) 2 Irrigation 4 Industrial 7 Lawn and garden (domestic) 10 Monitoring well Was a chemical/bacteriological sample submitted to Department? Yes _____ No X If yes, mo/day/yr sample was submitted _____ Water Well Disinfected? Yes X No _____			
5 TYPE OF BLANK CASING USED:					
1 Steel 3 RMP (SR) 5 Wrought Iron 8 Concrete tile CASING JOINTS: Glued X Clamped _____ 2 PVC 4 ABS 6 Asbestos-Cement 9 Other (specify below) Welded _____ 7 Fiberglass Threaded _____ Blank casing diameter 5 in. to 345 ft., Dia _____ in. to _____ ft., Dia _____ in. to _____ ft. Casing height above land surface _____ in., weight _____ lbs./ft. Wall thickness or gauge No. SDR 21					
TYPE OF SCREEN OR PERFORATION MATERIAL:					
1 Steel 3 Stainless steel 5 Fiberglass 7 PVC 10 Asbestos-cement 2 Brass 4 Galvanized steel 6 Concrete tile 8 RMP (SR) 11 Other (specify) _____ 12 None used (open hole) SCREEN OR PERFORATION OPENINGS ARE: 5 Gauzed wrapped 8 Saw cut 11 None (open hole) 1 Continuous slot 3 Mill slot 6 Wire wrapped 9 Drilled holes 2 Louvered shutter 4 Key punched 7 Torch cut 10 Other (specify) _____					
SCREEN-PERFORATED INTERVALS: From 220 ft. to 240 ft. From 260 ft. to 280 ft. From 320 ft. to 340 ft. From _____ ft. to _____ ft. GRAVEL PACK INTERVALS: From 25 ft. to 345 ft. From _____ ft. to _____ ft. From _____ ft. to _____ ft. From _____ ft. to _____ ft.					
6 GROUT MATERIAL: 1 Neat cement 2 Cement grout 3 Bentonite 4 Other _____					
Grout Intervals From 5 ft. to 25 ft. From _____ ft. to _____ ft. From _____ ft. to _____ ft.					
What is the nearest source of possible contamination:					
1 Septic tank 4 Lateral lines 7 Pit privy 10 Livestock pens 14 Abandoned water well 2 Sewer lines 5 Cess pool 8 Sewage lagoon 11 Fuel storage 15 Oil well/ Gas well 3 Watertight sewer lines 6 Seepage pit 9 Feedyard 12 Fertilizer storage 16 Other (specify below) None observed Direction from well? _____ How many feet? _____					
FROM TO CODE LITHOLOGIC LOG FROM TO PLUGGING INTERVALS					
0 16 Sand fine to coarse					
16 20 Sand & gravel					
20 71 Brown sandy clay ; little caliche					
71 114 Sand & gravel & a little clay					
114 169 Brown & gray sandy clay					
169 229 Sand; med to coarse					
229 279 Sand & gravel; loose					
279 340 Sand, med to coarse; little clay					
340 345 Shale					
7 CONTRACTOR'S OR LANDOWNER'S CERTIFICATION: This water well was (1) constructed, (2) reconstructed, or (3) plugged under my jurisdiction and was completed on (mo/day/yr) 1/19/05 and this record is true to the best of my knowledge and belief. Kansas Water Well Contractor's License No. 473 This Water Well Record was completed on (mo/day/yr) _____ under the business name of Tyler water well service Inc by (signature) _____					
INSTRUCTIONS: Please fill in blanks and circle the correct answers. Send three copies to Kansas Department of Health and Environment, Bureau of Water, Topeka, Kansas 66620-0001. Telephone: 913-296-5545. Send one to WATER WELL OWNER and retain one for your records.					