

1 LOCATION OF WATER WELL: COUNTY: 028 FINNEY	Fraction NE 1/4 SE 1/4 NW 1/4	Section Number 11	Township Number T 24 S	Range Number R 33 W
---	----------------------------------	----------------------	---------------------------	------------------------

Distance and direction from nearest town or city street address of well if located within city?

FROM GARDEN CITY; APPX 1 1/2 MILES WEST

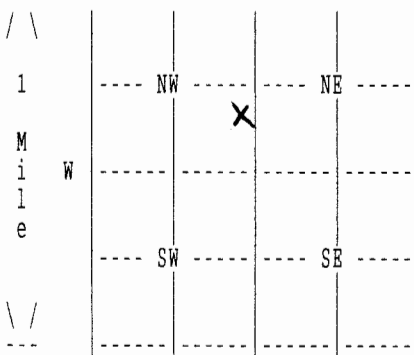
2 WATER WELL OWNER: WHEATLAND ELECTRIC

RR#, St. Address, Box # : PO BOX 1078

City, State, ZIP code : GARDEN CITY, KS 67846-

Board of Agriculture, Division of Water Resources

Application Number: 38,699

3 LOCATE WELL'S LOCATION WITH  
AN "X" IN SECTION BOX:

4 DEPTH OF COMPLETED WELL 660 ELEVATION: 0

Depth(s) Groundwater Encountered 1. 0 ft. 2. 0 ft. 3. 0 ft. 4. 0 ft.

WELL'S STATIC WATER LEVEL 126 ft. below land surface measured on mo/day/yr 05/05/05

Pump test data: Well water was 484 ft. after 4 hours pumping 250 gpm

Estimated Yield 0 gpm: Well water was 0 ft. after 0 hours pumping 0 gpm

Bore Hole Diameter 20 in. to 660 ft., and in. to 0 ft.

WELL WATER TO BE USED AS: 05 PUB. WTR SUP

Was a chemical/bacteriological sample submitted to department? No ;

If yes, mo/day/yr sample was submitted

Water well disinfected? Yes

5 TYPE OF BLANK CASING USED: 01 STEEL

CASING JOINTS: WELDED

Blank casing diameter 12 3/4 in. to 660 ft., Dia in. to 0 ft., Dia in. to 0 ft.

Casing height above land surface 12 in., weight 46 lbs/ft. Wall thickness or gauge No. .375

TYPE OF SCREEN OR PERFORATION MATERIAL: 03 STAINLESS ST

SCREEN OR PERFORATION OPENINGS ARE: 01 CONT. SLOT

SCREEN PERFORATED INTERVALS:

From 450 ft. to 580 ft., From 0 ft. to 0 ft.

From 610 ft. to 650 ft., From 0 ft. to 0 ft.

GRAVEL PACK INTERVALS:

From 90 ft. to 330 ft., From 0 ft. to 0 ft.

From 360 ft. to 660 ft., From 0 ft. to 0 ft.

6 GROUT MATERIAL 02 CEMENT GROUT

Grout Intervals: From 0 ft. to 90 ft., From 330 ft. to 360 ft., From 0 ft. to 0 ft.

What is the nearest source of possible contamination: NONE OBSERVED

Direction from well?

How many feet? 0

FROM	TO	LITHOLOGIC LOG	FROM	TO	PLUGGING INTERVALS
0	3	02 SILT 05 SAND			
3	4	05 SAND			
4	7	01 CLAY			
7	27	07 FINE SAND 08 MEDIUM SAND S-MD-LG GRAVEL			
27	35	04 SANDY CLAY			
35	48	05 SAND 13 FINE GRAVEL			
48	56	01 CLAY			
56	66	05 SAND 13 FINE GRAVEL			
66	155	01 CLAY 20 LIMESTONE			
155	167	05 SAND 13 FINE GRAVEL			

7 CONTRACTOR'S OR LANDOWNER'S CERTIFICATION: This water well was Constructed under my jurisdiction and was completed on (mo/day/year) 03/09/05 and this record is true to the best of my knowledge and belief. Kansas Water Well Contractor's License No. 145 This Water Well Record was completed on (mo/day/yr) 07/25/05 under the business name of HENKLE DRILLING & SUPPLY by (signature)

1 LOCATION OF WATER WELL:	Fraction	Section Number	Township Number	Range Number
COUNTY: 028 FINNEY	NE 1/4 SE 1/4 NW 1/4	11	T 24 S	R 33 W

2 WATER WELL OWNER: WHEATLAND ELECTRIC

RR#, St. Address, Box # : PO BOX 1078

City, State, ZIP code : GARDEN CITY, KS 67846-

Board of Agriculture, Division of Water Resources

Application Number: 38,699

FROM	TO	LITHOLOGIC LOG
167	181	01 CLAY
181	227	05 SAND 13 FINE GRAVEL
227	247	04 SANDY CLAY 05 SAND
247	265	07 FINE SAND 08 MEDIUM SAND 01 CLAY
265	291	04 SANDY CLAY 07 FINE SAND
291	302	05 SAND
302	312	20 LIMESTONE 31 CALICHE
312	376	19 SHALE 20 LIMESTONE
376	456	31 CALICHE
456	460	23 SANDSTONE
460	470	19 SHALE 20 LIMESTONE
470	496	31 CALICHE
496	512	23 SANDSTONE
512	518	31 CALICHE 23 SANDSTONE
518	545	23 SANDSTONE 31 CALICHE
545	566	31 CALICHE 23 SANDSTONE 20 LIMESTONE
566	575	23 SANDSTONE
575	606	31 CALICHE
606	612	23 SANDSTONE
612	635	31 CALICHE 23 SANDSTONE
635	640	23 SANDSTONE
640	650	31 CALICHE 20 LIMESTONE 23 SANDSTONE
650	670	31 CALICHE 20 LIMESTONE

7 CONTRACTOR'S OR LANDOWNER'S CERTIFICATION: This water well was Constructed under my jurisdiction and was completed on (mo/day/year) 03/09/05 and this record is true to the best of my knowledge and belief. Kansas

Water Well Contractor's License No. 145

under the business name of HENKLE DRILLING &amp; SUPPLY

This Water Well Record was completed on (mo/day/yr) 07/25/05

by (signature)

