

WATER WELL RECORD Form WWC-5 KSA 82a-1212


1 LOCATION OF WATER WELL:	Fraction	Section Number	Township Number	Range Number
COUNTY: 028 FINNEY	SW 1/4 NW 1/4 NE 1/4	14	T 24 S	R 33 W

Distance and direction from nearest town or city street address of well if located within city?
 FROM GARDEN CITY; APPX 1 1/2 MILES WEST

2 WATER WELL OWNER: THE GARDEN CITY COMPANY
 RR#, St. Address, Box #: PO BOX 597
 City, State, ZIP code: GARDEN CITY, KS 67846-0597
 Board of Agriculture, Division of Water Resources
 Application Number: FI171 & 17,230

3 LOCATE WELL'S LOCATION WITH
 AN "X" IN SECTION BOX:

4 DEPTH OF COMPLETED WELL 338 ELEVATION: 0
 Depth(s) Groundwater Encountered 1. 0 ft. 2. 0 ft. 3. 0 ft.

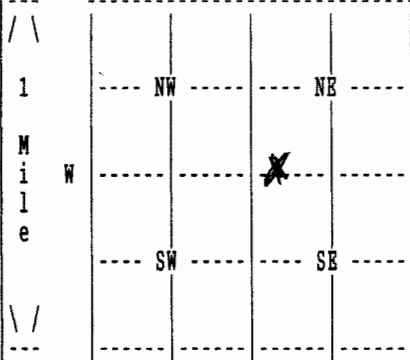

WELL'S STATIC WATER LEVEL 98 ft. below land surface measured on mo/day/yr 05/15/06
 Pump test data: Well water was 258 ft. after 4 hours pumping 1331 gpm

Estimated Yield 0 gpm: Well water was 0 ft. after 0 hours pumping 0 gpm

Bore Hole Diameter 24 in. to 338 ft., and in. to 0 ft.

WELL WATER TO BE USED AS: 02 IRRIGATION

Was a chemical/bacteriological sample submitted to department? No;
 If yes, mo/day/yr sample was submitted Water well disinfected? Yes

5 TYPE OF BLANK CASING USED: 01 STEEL CASING JOINTS: WELDED
 Blank casing diameter 16 in. to 338 ft., Dia in. to 0 ft., Dia in. to 0 ft.
 Casing height above land surface 12 in., weight 42 lbs/ft. Wall thickness or gauge No. .250
 TYPE OF SCREEN OR PERFORATION MATERIAL: 01 STEEL
 SCREEN OR PERFORATION OPENINGS ARE: 01 CONT. SLOT

SCREEN PERFORATED INTERVALS:	From 220 ft. to 240 ft., From 0 ft. to 0 ft.
	From 253 ft. to 333 ft., From 0 ft. to 0 ft.
GRAVEL PACK INTERVALS:	From 20 ft. to 338 ft., From 0 ft. to 0 ft.
	From 0 ft. to 0 ft., From 0 ft. to 0 ft.

6 GROUT MATERIAL 03 BENTONITE
 Grout Intervals: From 0 ft. to 20 ft., From 0 ft. to 0 ft., From 0 ft. to 0 ft.
 What is the nearest source of possible contamination: NONE OBSERVED
 Direction from well? How many feet? 0

FROM	TO	LITHOLOGIC LOG	FROM	TO	PLUGGING INTERVALS
0	3	02 SILT			
3	8	07 FINE SAND			
8	73	05 SAND 11 GRAVEL			
73	176	04 SANDY CLAY 31 CALICHE 20 LIMESTONE			
176	189	05 SAND 13 FINE GRAVEL			
189	194	04 SANDY CLAY			
194	205	05 SAND			
205	214	04 SANDY CLAY 05 SAND			
214	240	05 SAND 13 FINE GRAVEL			
240	257	04 SANDY CLAY			

7 CONTRACTOR'S OR LANDOWNER'S CERTIFICATION: This water well was Constructed under my jurisdiction and was completed on (mo/day/year) 05/13/06 and this record is true to the best of my knowledge and belief. Kansas
 Water Well Contractor's License No. 145 This Water Well Record was completed on (mo/day/yr) 07/07/06
 under the business name of HENKLE DRILLING & SUPPLY by (signature)

(Continued)

WATER WELL RECORD Form WWC-5 KSA 82a-1212

1 LOCATION OF WATER WELL:	Fraction	Section Number	Township Number	Range Number
COUNTY: 028 FINNEY	SW 1/4 NW 1/4 NE 1/4	14	T 24 S	R 33 W

2 WATER WELL OWNER: THE GARDEN CITY COMPANY
RR#, St. Address, Box # : PO BOX 597
City, State, ZIP code : GARDEN CITY, KS 67846-0597

Board of Agriculture, Division of Water Resources
Application Number: FI171 & 17,230

FROM	TO	LITHOLOGIC LOG
257	272	05 SAND
272	277	04 SANDY CLAY
277	298	07 FINE SAND 08 MEDIUM SAND 01 CLAY
298	312	05 SAND 13 FINE GRAVEL
312	319	04 SANDY CLAY 05 SAND
319	333	05 SAND
333	338	31 CALICHE
338	340	19 SHALE

7 CONTRACTOR'S OR LANDOWNER'S CERTIFICATION: This water well was Constructed under my jurisdiction and was completed on (mo/day/year) 05/13/06 and this record is true to the best of my knowledge and belief. Kansas Water Well Contractor's License No. 145 This Water Well Record was completed on (mo/day/yr) 07/07/06 under the business name of HENKLE DRILLING & SUPPLY

by (signature)

Bruno J. Kichum