

1 LOCATION OF WATER WELL:	Fraction County: Finney	NE $\frac{1}{4}$ SE $\frac{1}{4}$ SW $\frac{1}{4}$	Section Number 12	Township Number T 24 S	Range Number R 33 W
---------------------------	-----------------------------------	--	-----------------------------	----------------------------------	-------------------------------

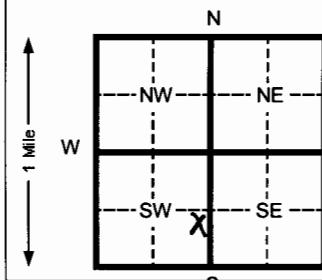
Distance and direction from nearest town or city street address of well if located within city?

Massey Ferguson Road, Garden City, Kansas2 WATER WELL OWNER: **Garden City Coop Bulk Plant**RR#, St. Address, Box #: **1304 Masset Ferguson Road**

Board of Agriculture, Division of Water Resources

City, State, ZIP Code: **Garden City, Ks 67846**

Application Number:

3 LOCATE WELL'S LOCATON WITH
AN "X" IN SECTION BOX:

4 DEPTH OF COMPLETED WELL	51	ft. ELEVATION:	ft. 2	ft. 3	Ft.
Depth(s) Groundwater Encountered	1	31			
WELL'S STATIC WATER LEVEL ft. below land surface measured on mo/day/yr					
Pump test data: Well water was		Ft. after	hours pumping	Gpm	
Est. Yield	Gpm:	Well water was			
Bore Hole Diameter	8.625	In. to	51	Ft. and	Ft.
WELL WATER TO BE USED AS:	5 Public water supply	8 Air conditioning	11 Injection well		
1 Domestic	3 Feed lot	6 Oil field water supply	9 Dewatering	12 Other (Specify below)	
2 Irrigation	4 Industrial	7 Lawn and garden (domestic)	10 Monitoring well	MW-1R	

Was a chemical/bacteriological sample submitted to Department? Yes No If yes, mo/day/yr sample was Submitted Water Well Disinfected? Yes No

5 TYPE OF BLANK CASING USED:

1 Steel 3 RMP (SR)
2 PVC 4 ABS

5 Wrought Iron 8 Concrete tile CASING JOINTS: Glued Clamped
6 Asbestos-Cement 9 Other (specify below) Welded
7 Fiberglass Threaded

Blank casing diameter **2** in. to **20** Ft., Dia in. to ft., Dia in. to ft.

Casing height above land surface **FLUSH** in., weight **SCH 40** Lbs./ft. Wall thickness or gauge No.

TYPE OF SCREEN OR PERFORATION MATERIAL:

1 Steel	3 Stainless steel	5 Fiberglass	8 RMP (SR)	11 Other (specify)
2 Brass	4 Galvanized steel	6 Concrete tile	9 ABS	12 None used (open hole)

SCREEN OR PERFORATION OPENINGS ARE: 5 Gauzed wrapped 8 Saw cut 11 None (open hole)

1 Continuous slot 3 Mill slot 6 Wire wrapped 9 Drilled holes
2 Louvered shutter 4 Key punched 7 Torch cut 10 Other (specify)

SCREEN-PERFORATED INTERVALS: From **20** ft. to **50** ft. From ft. to ft. From ft. to ft.

SAND PACK INTERVALS: From **18** ft. to **51** ft. From ft. to ft. From ft. to ft.

6 GROUT MATERIAL: 1 Neat cement 2 Cement grout 3 Bentonite 4 Other

Grout Intervals From **3** **16** Ft. to **18** Ft. From **2** **0** Ft. to **16** Ft. From ft. to ft.

What is the nearest source of possible contamination:

1 Septic tank	4 Lateral lines	7 Pit privy	10 Livestock pens	14 Abandoned water well
2 Sewer lines	5 Cess pool	8 Sewage lagoon	11 Fuel storage	15 Oil well/ Gas well
3 Watertight sewer lines	6 Seepage pit	9 Feedyard	12 Fertilizer storage	16 Other (specify below)

Contaminated Site

Direction from well?

How many feet?

FROM	TO	CODE	LITHOLOGIC LOG	FROM	TO	PLUGGING INTERVALS
0	25		Previous well			
25	47		Sand (SW) fine,			
47	51		Sandy Clay, fine grain			
51	TD		End of Borehole			

**This well was drilled to
A deeper depth in same
Location as previous well**

7 CONTRACTOR'S OR LANDOWNER'S CERTIFICATION: This water well was (x) constructed, (2) reconstructed, or (3) plugged under my jurisdiction and w
Completed on (mo/day/yr) **10/18/06** And this record is true to the best of my knowledge and belief. Kansas

Water Well Contractor's License No. **585** This Water Well Record was completed on (mo/day/yr) **11/01/06**

under the business name of **Associated Environmental, Inc.** By (signature) **Bradley J. Johnson**

INSTRUCTIONS: Please fill in blanks and circle the correct answers. Send three copies to Kansas Department of Health and Environment, Bureau of Water, Topeka, Kansas 66620-0001. Telephone: 913-296-5545. Send one to WATER WELL OWNER and retain one for your records.