

"Corrected

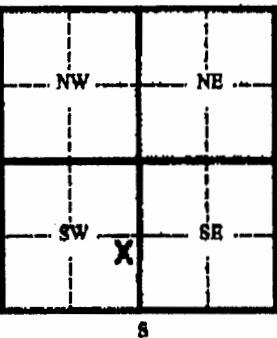
WATER WELL PLUGGING RECORD

Form WWC-5P

KSA 82a-1212

ID No.

MW-6

1 LOCATION OF WATER WELL:		Fraction County: Finney	NE $\frac{1}{4}$ SE $\frac{1}{4}$ SW $\frac{1}{4}$	Section Number 12	Township Number 24 S	Range Number 33 W																												
Distance and direction from nearest town or city street address of well if located within city? 1304 Massey Ferguson Road, Garden City, KS 67846																																		
2 WATER WELL OWNER: Garden City Coop Bulk Plant RR#, St. Address, Box # 1304 Massey Ferguson Road City, State, ZIP Code Garden City, KS 67846 Board of Agriculture, Division of Water Resources Application Number:																																		
3 MARK WELL'S LOCATION WITH AN 'X' IN SECTION BOX:		4 DEPTH OF WELL 23 ft. WELL'S STATIC WATER LEVEL dry ft. WELL WAS USED AS:																																
		<table border="0"> <tr> <td>1 Domestic</td> <td>5 Public Water Supply</td> <td>9 Dewatering</td> </tr> <tr> <td>2 Irrigation</td> <td>6 Oil Field Water Supply</td> <td>10 Monitoring Well</td> </tr> <tr> <td>3 Feedlot</td> <td>7 Lawn and Garden (domestic)</td> <td>11 Injection Well</td> </tr> <tr> <td>4 Industrial</td> <td>8 Air Conditioning</td> <td>12 Other</td> </tr> </table>					1 Domestic	5 Public Water Supply	9 Dewatering	2 Irrigation	6 Oil Field Water Supply	10 Monitoring Well	3 Feedlot	7 Lawn and Garden (domestic)	11 Injection Well	4 Industrial	8 Air Conditioning	12 Other																
1 Domestic	5 Public Water Supply	9 Dewatering																																
2 Irrigation	6 Oil Field Water Supply	10 Monitoring Well																																
3 Feedlot	7 Lawn and Garden (domestic)	11 Injection Well																																
4 Industrial	8 Air Conditioning	12 Other																																
Was a chemical/bacteriological sample submitted to Department? Yes No If yes, mo/day/yr sample was submitted Water Well Disinfected: Yes No																																		
5 TYPE OF BLANK CASING USED: <table border="0"> <tr> <td>1 Steel</td> <td>3 RMP (SR)</td> <td>5 Wrought</td> <td>7 Fiberglass</td> <td>9 Other (specify below)</td> </tr> <tr> <td>2 PVC</td> <td>4 ABC</td> <td>6 Asbestos-Cement</td> <td>8 Concrete Tile</td> <td></td> </tr> </table>							1 Steel	3 RMP (SR)	5 Wrought	7 Fiberglass	9 Other (specify below)	2 PVC	4 ABC	6 Asbestos-Cement	8 Concrete Tile																			
1 Steel	3 RMP (SR)	5 Wrought	7 Fiberglass	9 Other (specify below)																														
2 PVC	4 ABC	6 Asbestos-Cement	8 Concrete Tile																															
Blank casing diameter 2 in. Was casing pulled? Yes <input checked="" type="checkbox"/> No If yes, how much removed 3 ft.																																		
Casing height above or below land surface -36 in.																																		
6 GROUT PLUG MATERIAL: 1 Neat cement 2 Cement grout 3 Bentonite 4 Other																																		
Grout Plug Intervals From 0 ft. to 23 ft. From ft. to ft. From ft. to ft.																																		
What is the nearest source of possible contamination: <table border="0"> <tr> <td>1 Septic tank</td> <td>6 Seepage pit</td> <td>11 Fuel storage</td> <td>16 Other (specify below)</td> </tr> <tr> <td>2 Sewer lines</td> <td>7 Pit privy</td> <td>12 Fertilizer storage</td> <td></td> </tr> <tr> <td>3 Watertight sewer lines</td> <td>8 Sewage lagoon</td> <td>13 Insecticide storage</td> <td></td> </tr> <tr> <td>4 Lateral lines</td> <td>9 Feedyard</td> <td>14 Abandoned water well</td> <td></td> </tr> <tr> <td>5 Cess Pool</td> <td>10 Livestock pens</td> <td>15 Oil well/ Gas well</td> <td></td> </tr> </table>							1 Septic tank	6 Seepage pit	11 Fuel storage	16 Other (specify below)	2 Sewer lines	7 Pit privy	12 Fertilizer storage		3 Watertight sewer lines	8 Sewage lagoon	13 Insecticide storage		4 Lateral lines	9 Feedyard	14 Abandoned water well		5 Cess Pool	10 Livestock pens	15 Oil well/ Gas well									
1 Septic tank	6 Seepage pit	11 Fuel storage	16 Other (specify below)																															
2 Sewer lines	7 Pit privy	12 Fertilizer storage																																
3 Watertight sewer lines	8 Sewage lagoon	13 Insecticide storage																																
4 Lateral lines	9 Feedyard	14 Abandoned water well																																
5 Cess Pool	10 Livestock pens	15 Oil well/ Gas well																																
Direction from well? How many feet?																																		
<table border="1"> <thead> <tr> <th>FROM</th> <th>TO</th> <th>CODE</th> <th>PLUGGING MATERIALS</th> </tr> </thead> <tbody> <tr> <td>0</td> <td>23</td> <td></td> <td>Bentonite grout</td> </tr> <tr> <td></td> <td></td> <td></td> <td></td> </tr> </tbody> </table>							FROM	TO	CODE	PLUGGING MATERIALS	0	23		Bentonite grout																				
FROM	TO	CODE	PLUGGING MATERIALS																															
0	23		Bentonite grout																															
<p>7 CONTRACTOR'S OR LANDOWNER'S CERTIFICATION: This water well was plugged under my jurisdiction and was completed on (mo/day/yr) 11/18/08 and this record is true to the best of my knowledge and belief. Kansas Water Well Contractor's License No. SS4 This Water Well Record was completed on (mo/day/yr) 12/2/08 under the business name of <i>Nielsdotter</i> Bluestem Environmental Engineering, Inc. by (signature) <i>Greg M. Wogalter</i></p>																																		
INSTRUCTIONS: Please fill in blanks and circle the correct answers. Send three copies to Kansas Department of Health and Environment, Bureau of Water, 1000 S W Jackson St., Ste. 420, Topeka, Kansas 66620-0001. Telephone: 785-296-3585. Send one to Water Well Owner and retain one for your records.																																		