

Corrected

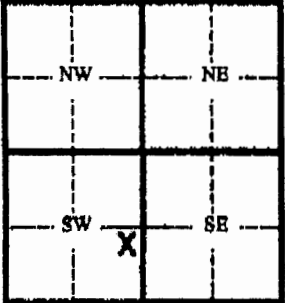
WATER WELL PLUGGING RECORD

Form WWC-5P

KSA 82a-1212

ID No.

IAS-1

1 LOCATION OF WATER WELL:		Fraction	Section Number	Township Number	Range Number																																
County: <u>Finney</u>		<u>NE 1/4 SE 1/4 SW 1/4</u>	<u>12</u>	<u>24 S</u>	<u>33 W</u>																																
Distance and direction from nearest town or city street address of well if located within city? <u>1304 Massey Ferguson Road, Garden City, KS 67846</u>																																					
2 WATER WELL OWNER: <u>Garden City Coop Bulk Plant</u> RR#, St. Address, Box # <u>1304 Massey Ferguson Road</u> City, State, ZIP Code <u>Garden City, KS 67846</u>			Board of Agriculture, Division of Water Resources Application Number:																																		
3 MARK WELL'S LOCATION WITH AN "X" IN SECTION BOX:		4 DEPTH OF WELL <u>48</u> ft. WELL'S STATIC WATER LEVEL <u>36</u> ft. WELL WAS USED AS: <table style="width:100%;"><tr><td>1 Domestic</td><td>5 Public Water Supply</td><td>9 Dewatering</td></tr><tr><td>2 Irrigation</td><td>6 Oil Field Water Supply</td><td>10 Monitoring Well</td></tr><tr><td>3 Feedlot</td><td>7 Lawn and Garden (domestic)</td><td><u>11</u> Injection Well</td></tr><tr><td>4 Industrial</td><td>8 Air Conditioning</td><td>12 Other</td></tr></table> Was a chemical/bacteriological sample submitted to Department? Yes <u> </u> No <u> </u> If yes, mo/day/yr sample was submitted <u> </u> Water Well Disinfected: Yes <u> </u> No <u> </u>				1 Domestic	5 Public Water Supply	9 Dewatering	2 Irrigation	6 Oil Field Water Supply	10 Monitoring Well	3 Feedlot	7 Lawn and Garden (domestic)	<u>11</u> Injection Well	4 Industrial	8 Air Conditioning	12 Other																				
1 Domestic	5 Public Water Supply	9 Dewatering																																			
2 Irrigation	6 Oil Field Water Supply	10 Monitoring Well																																			
3 Feedlot	7 Lawn and Garden (domestic)	<u>11</u> Injection Well																																			
4 Industrial	8 Air Conditioning	12 Other																																			
<div style="text-align: center;">N X W E  S</div>																																					
5 TYPE OF BLANK CASING USED: <table style="width:100%;"><tr><td>1 Steel</td><td>3 RMP (SR)</td><td>5 Wrought</td><td>7 Fiberglass</td><td>9 Other (specify below)</td></tr><tr><td><u>2</u> PVC</td><td>4 ABC</td><td>6 Asbestos-Cement</td><td>8 Concrete Tile</td><td></td></tr></table> Blank casing diameter <u>2</u> in. Was casing pulled? Yes <u>X</u> No <u> </u> If yes, how much <u>removed 3 ft.</u> Casing height above or below land surface <u>-36</u> in.						1 Steel	3 RMP (SR)	5 Wrought	7 Fiberglass	9 Other (specify below)	<u>2</u> PVC	4 ABC	6 Asbestos-Cement	8 Concrete Tile																							
1 Steel	3 RMP (SR)	5 Wrought	7 Fiberglass	9 Other (specify below)																																	
<u>2</u> PVC	4 ABC	6 Asbestos-Cement	8 Concrete Tile																																		
6 GROUT PLUG MATERIAL: 1 Neat cement 2 Cement grout <u>3</u> Bentonite 4 Other <u> </u> Grout Plug Intervals From <u>0</u> ft. to <u>48</u> ft. From <u> </u> ft. to <u> </u> ft. From <u> </u> ft. to <u> </u> ft. What is the nearest source of possible contamination: <table style="width:100%;"><tr><td>1 Septic tank</td><td>6 Seepage pit</td><td><u>11</u> Fuel storage</td><td>16 Other (specify below)</td></tr><tr><td>2 Sewer lines</td><td>7 Pit privy</td><td>12 Fertilizer storage</td><td></td></tr><tr><td>3 Watertight sewer lines</td><td>8 Sewage lagoon</td><td>13 Insecticide storage</td><td></td></tr><tr><td>4 Lateral lines</td><td>9 Feedyard</td><td>14 Abandoned water well</td><td></td></tr><tr><td>5 Cess Pool</td><td>10 Livestock pens</td><td>15 Oil well/ Gas well</td><td></td></tr></table> Direction from well? <u> </u> How many feet? <u> </u>						1 Septic tank	6 Seepage pit	<u>11</u> Fuel storage	16 Other (specify below)	2 Sewer lines	7 Pit privy	12 Fertilizer storage		3 Watertight sewer lines	8 Sewage lagoon	13 Insecticide storage		4 Lateral lines	9 Feedyard	14 Abandoned water well		5 Cess Pool	10 Livestock pens	15 Oil well/ Gas well													
1 Septic tank	6 Seepage pit	<u>11</u> Fuel storage	16 Other (specify below)																																		
2 Sewer lines	7 Pit privy	12 Fertilizer storage																																			
3 Watertight sewer lines	8 Sewage lagoon	13 Insecticide storage																																			
4 Lateral lines	9 Feedyard	14 Abandoned water well																																			
5 Cess Pool	10 Livestock pens	15 Oil well/ Gas well																																			
<table border="1" style="width:100%; border-collapse: collapse;"><thead><tr><th>FROM</th><th>TO</th><th>CODE</th><th>PLUGGING MATERIALS</th></tr></thead><tbody><tr><td>0</td><td>48</td><td></td><td>Bentonite grout</td></tr><tr><td> </td><td> </td><td> </td><td> </td></tr><tr><td> </td><td> </td><td> </td><td> </td></tr><tr><td> </td><td> </td><td> </td><td> </td></tr><tr><td> </td><td> </td><td> </td><td> </td></tr><tr><td> </td><td> </td><td> </td><td> </td></tr><tr><td> </td><td> </td><td> </td><td> </td></tr></tbody></table>				FROM	TO	CODE	PLUGGING MATERIALS	0	48		Bentonite grout																									<div style="border: 1px solid black; padding: 5px; width: fit-content; margin: 0 auto;">RECEIVED</div> <div style="margin-top: 10px;">JAN 08 2009</div> <div style="margin-top: 10px;">BUREAU OF WATER</div>	
FROM	TO	CODE	PLUGGING MATERIALS																																		
0	48		Bentonite grout																																		
7 CONTRACTOR'S OR LANDOWNER'S CERTIFICATION: This water well was plugged under my jurisdiction and was completed on (mo/day/yr) <u>11/18/08</u> and this record is true to the best of my knowledge and belief. Kansas Water Well Contractor's License No. <u>554</u> This Water Well Record was completed on (mo/day/yr) <u>12/2/08</u> under the business name of <u>Bluestem Environmental Engineering, Inc.</u> by (signature) <u>Nick Holt</u> <u>Jay C. Woolf</u>																																					
INSTRUCTIONS: Please fill in blanks and circle the correct answers. Send three copies to Kansas Department of Health and Environment, Bureau of Water, 1000 S W Jackson St., Ste. 420, Topeka, Kansas 66620-0001. Telephone: 785-298-3586. Send one to Water Well Owner and retain one for your records.																																					