

"Corrected

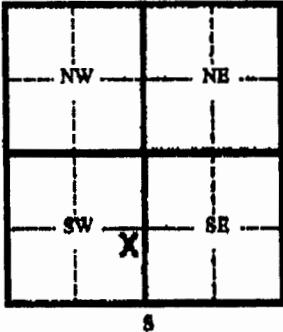
WATER WELL PLUGGING RECORD

Form WWC-5P

KSA 82a-1212

ID No.

PR-14

1 LOCATION OF WATER WELL:	Fraction County: Finney		NE $\frac{1}{4}$ SE $\frac{1}{4}$ SW $\frac{1}{4}$	Section Number 12	Township Number 24 S	Range Number 33 W	
Distance and direction from nearest town or city street address of well if located within city? 1304 Massey Ferguson Road, Garden City, KS 67846	
2 WATER WELL OWNER:	Garden City Coop Bulk Plant RR#, St. Address, Box # 1304 Massey Ferguson Road City, State, ZIP Code ; Garden City, KS 67846			Board of Agriculture, Division of Water Resources Application Number:	
3 MARK WELL'S LOCATON WITH AN "X" IN SECTION BOX:			4 DEPTH OF WELL 25 ft.	WELL'S STATIC WATER LEVEL dry ft.	
WELL WAS USED AS:	
<input type="checkbox"/> 1 Domestic <input type="checkbox"/> 5 Public Water Supply <input type="checkbox"/> 9 Dewatering <input type="checkbox"/> 2 Irrigation <input type="checkbox"/> 6 Oil Field Water Supply <input type="checkbox"/> 10 Monitoring Well <input type="checkbox"/> 3 Feedlot <input type="checkbox"/> 7 Lawn and Garden (domestic) <input type="checkbox"/> 11 Injection Well <input type="checkbox"/> 4 Industrial <input type="checkbox"/> 8 Air Conditioning <input checked="" type="checkbox"/> 12 Other Product recovery	
Was a chemical/bacteriological sample submitted to Department? Yes ... No ...	
If yes, mo/day/yr sample was submitted	
Water Well Disinfected: Yes ... No ...	
5 TYPE OF BLANK CASING USED:	1 Steel	3 RMP (SR)	5 Wrought	7 Fiberglass	9 Other (specify below)	
	<input checked="" type="checkbox"/> PVC	4 ABC	6 Asbestos-Cement	8 Concrete Tile	
Blank casing diameter	5 in.	Was casing pulled?	Yes <input checked="" type="checkbox"/>	No	If yes, how much	removed 3 ft	
Casing height above or below land surface -36 in.	
6 GROUT PLUG MATERIAL:	1 Neat cement	2 Cement grout	3 Bentonite	4 Other	
Grout Plug Intervals	From 0 ft. to 25 ft.	From	ft. to	ft. From	ft. to	ft.	
What is the nearest source of possible contamination:	
1 Septic tank	6 Seepage pit	11 Fuel storage	16 Other (specify below)	
2 Sewer lines	7 Pit privy	12 Fertilizer storage	
3 Watertight sewer lines	8 Sewage lagoon	13 Insecticide storage	
4 Lateral lines	9 Feedyard	14 Abandoned water well	
5 Cess Pool	10 Livestock pens	15 Oil well/ Gas well	
Direction from well? How many feet?	
<table border="1"> <thead> <tr> <th>FROM</th> <th>TO</th> <th>CODE</th> <th colspan="4">PLUGGING MATERIALS</th> </tr> </thead> <tbody> <tr> <td>0</td> <td>25</td> <td></td> <td colspan="4">Bentonite grout</td> </tr> <tr> <td></td> <td></td> <td></td> <td colspan="4"></td> </tr> </tbody> </table>							FROM	TO	CODE	PLUGGING MATERIALS				0	25		Bentonite grout	
FROM	TO	CODE	PLUGGING MATERIALS	
0	25		Bentonite grout	
7 CONTRACTOR'S OR LANDOWNER'S CERTIFICATION:	This water well was plugged under my jurisdiction and was completed on (mo/day/yr) 11/19/08 and this record is true to the best of my knowledge and belief. Kansas Water Well Contractor's License No. 554 This Water Well Record was completed on (mo/day/yr) 12/2/08 under the business name of <i>Nichols</i> <i>Jay C. Nichols</i> Bluestem Environmental Engineering, Inc.	
INSTRUCTIONS: Please fill in blanks and circle the correct answers. Send three copies to Kansas Department of Health and Environment, Bureau of Water, 1000 S W Jackson St., Ste. 420, Topeka, Kansas 66620-0001. Telephone: 785-296-3566. Send one to Water Well Owner and retain one for your records.	

RECEIVED

JAN 08 2009

BUREAU OF WATER