

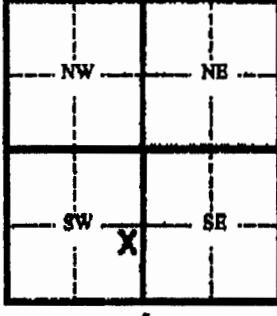
## WATER WELL PLUGGING RECORD

Form WWC-5P

KSA 82a-1212

ID No.

PR-18

1 LOCATION OF WATER WELL: Fraction County: Finney		NE $\frac{1}{4}$ SE $\frac{1}{4}$ SW $\frac{1}{4}$	Section Number 12	Township Number 24 S	Range Number 33 W	
Distance and direction from nearest town or city street address of well if located within city? 1304 Massey Ferguson Road, Garden City, KS 67846	
2 WATER WELL OWNER: Garden City Coop Bulk Plant RR#, St. Address, Box # 1304 Massey Ferguson Road City, State, ZIP Code Garden City, KS 67846	
3 MARK WELL'S LOCATON WITH AN "X" IN SECTION BOX:  	
<table border="0"> <tr> <td>4</td> <td>DEPTH OF WELL</td> <td>25</td> <td>ft.</td> </tr> <tr> <td colspan="4">WELL'S STATIC WATER LEVEL</td> </tr> <tr> <td colspan="4">dry ft.</td> </tr> <tr> <td colspan="6">WELL WAS USED AS:</td> </tr> <tr> <td colspan="2">1 Domestic</td> <td colspan="2">5 Public Water Supply</td> <td colspan="2">9 Dewatering</td> </tr> <tr> <td colspan="2">2 Irrigation</td> <td colspan="2">6 Oil Field Water Supply</td> <td colspan="2">10 Monitoring Well</td> </tr> <tr> <td colspan="2">3 Feedlot</td> <td colspan="2">7 Lawn and Garden (domestic)</td> <td colspan="2">11 Injection Well</td> </tr> <tr> <td colspan="2">4 Industrial</td> <td colspan="2">8 Air Conditioning</td> <td colspan="2">12 Other Product recovery</td> </tr> </table>						4	DEPTH OF WELL	25	ft.	WELL'S STATIC WATER LEVEL				dry ft.				WELL WAS USED AS:						1 Domestic		5 Public Water Supply		9 Dewatering		2 Irrigation		6 Oil Field Water Supply		10 Monitoring Well		3 Feedlot		7 Lawn and Garden (domestic)		11 Injection Well		4 Industrial		8 Air Conditioning		12 Other Product recovery	
4	DEPTH OF WELL	25	ft.	
WELL'S STATIC WATER LEVEL	
dry ft.	
WELL WAS USED AS:	
1 Domestic		5 Public Water Supply		9 Dewatering	
2 Irrigation		6 Oil Field Water Supply		10 Monitoring Well	
3 Feedlot		7 Lawn and Garden (domestic)		11 Injection Well	
4 Industrial		8 Air Conditioning		12 Other Product recovery	
<p>Was a chemical/bacteriological sample submitted to Department? Yes ... No ...</p> <p>If yes, mo/day/yr sample was submitted</p> <p>Water Well Disinfected: Yes ... No ...</p>	
<p>5 TYPE OF BLANK CASING USED:</p> <table border="0"> <tr> <td>1 Steel</td> <td>3 RMP (SR)</td> <td>5 Wrought</td> <td>7 Fiberglass</td> <td>9 Other (specify below)</td> </tr> <tr> <td><input checked="" type="radio"/> 2 PVC</td> <td>4 ABC</td> <td>6 Asbestos-Cement</td> <td>8 Concrete Tile</td> <td></td> </tr> </table> <p>Blank casing diameter ..... 5 in. Was casing pulled? Yes <input checked="" type="checkbox"/> No ..... If yes, how much <input checked="" type="checkbox"/> removed 3 ft.</p> <p>Casing height above or below land surface ..... -36 in.</p>						1 Steel	3 RMP (SR)	5 Wrought	7 Fiberglass	9 Other (specify below)	<input checked="" type="radio"/> 2 PVC	4 ABC	6 Asbestos-Cement	8 Concrete Tile																																	
1 Steel	3 RMP (SR)	5 Wrought	7 Fiberglass	9 Other (specify below)	
<input checked="" type="radio"/> 2 PVC	4 ABC	6 Asbestos-Cement	8 Concrete Tile	
<p>6 GROUT PLUG MATERIAL: 1 Neat cement 2 Cement grout <input checked="" type="radio"/> 3 Bentonite 4 Other</p> <p>Grout Plug Intervals From 0 ft. to 25 ft. From ..... ft. to ..... ft. From ..... ft. to ..... ft.</p> <p>What is the nearest source of possible contamination:</p> <table border="0"> <tr> <td>1 Septic tank</td> <td>6 Seepage pit</td> <td><input checked="" type="radio"/> 11 Fuel storage</td> <td>16 Other (specify below)</td> </tr> <tr> <td>2 Sewer lines</td> <td>7 Pit privy</td> <td>12 Fertilizer storage</td> <td></td> </tr> <tr> <td>3 Watertight sewer lines</td> <td>8 Sewage lagoon</td> <td>13 Insecticide storage</td> <td></td> </tr> <tr> <td>4 Lateral lines</td> <td>9 Feedyard</td> <td>14 Abandoned water well</td> <td></td> </tr> <tr> <td>5 Cess Pool</td> <td>10 Livestock pens</td> <td>15 Oil well/ Gas well</td> <td></td> </tr> </table>						1 Septic tank	6 Seepage pit	<input checked="" type="radio"/> 11 Fuel storage	16 Other (specify below)	2 Sewer lines	7 Pit privy	12 Fertilizer storage		3 Watertight sewer lines	8 Sewage lagoon	13 Insecticide storage		4 Lateral lines	9 Feedyard	14 Abandoned water well		5 Cess Pool	10 Livestock pens	15 Oil well/ Gas well																							
1 Septic tank	6 Seepage pit	<input checked="" type="radio"/> 11 Fuel storage	16 Other (specify below)	
2 Sewer lines	7 Pit privy	12 Fertilizer storage	
3 Watertight sewer lines	8 Sewage lagoon	13 Insecticide storage	
4 Lateral lines	9 Feedyard	14 Abandoned water well	
5 Cess Pool	10 Livestock pens	15 Oil well/ Gas well	
<p>Direction from well? ..... How many feet? .....</p> <table border="1"> <thead> <tr> <th>FROM</th> <th>TO</th> <th>CODE</th> <th>PLUGGING MATERIALS</th> </tr> </thead> <tbody> <tr> <td>0</td> <td>25</td> <td></td> <td>Bentonite grout</td> </tr> <tr> <td></td> <td></td> <td></td> <td></td> </tr> </tbody> </table>						FROM	TO	CODE	PLUGGING MATERIALS	0	25		Bentonite grout																																		
FROM	TO	CODE	PLUGGING MATERIALS	
0	25		Bentonite grout	
<p>7 CONTRACTOR'S OR LANDOWNER'S CERTIFICATION: This water well was plugged under my jurisdiction and was completed on (mo/day/yr) 11/19/08 and this record is true to the best of my knowledge and belief. Kansas Water Well Contractor's License No. 554 This Water Well Record was completed on (mo/day/yr) 12/2/08 under the business name of <i>Nichols</i> <i>Bluestem Environmental Engineering, Inc.</i> by (signature) <i>Jerry C. Wooters</i></p>	
<p>INSTRUCTIONS: Please fill in blanks and circle the correct answers. Send three copies to Kansas Department of Health and Environment, Bureau of Water, 1000 S W Jackson St., Ste. 420, Topeka, Kansas 66620-0001. Telephone: 785-296-3685. Send one to Water Well Owner and retain one for your records.</p>	

RECEIVED  
JAN 08 2009  
BUREAU OF WATER