

MW-11

WATER WELL RECORD


Form WWC-5

Division of Water Resources App. No.

1 LOCATION OF WATER WELL: County: Finney, Fraction NE 1/4 NE 1/4 NE 1/4, Section Number 36, Township No. T 24 S, Range Number R 33 E W

Street/Rural Address of Well Location; if unknown, distance & direction from nearest town or intersection: If at owner's address, check here. Global Positioning System (GPS) information: Latitude: N 37° 55' 50", Longitude: W 100° 53' 31", Elevation: Datum: WGS 84, NAD 83, NAD 27

2 WATER WELL OWNER: Crop Production Services Inc, RR#, Street Address, Box #: 2025 South Old Hwy 83, City, State, ZIP Code: Garden City, KS. Collection Method: Digital Map/Photo, Topographic Map, Land Survey

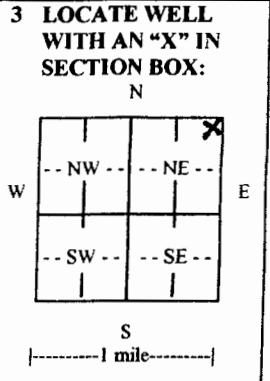

3 LOCATE WELL WITH AN 'X' IN SECTION BOX: N, W, E, S. 4 DEPTH OF COMPLETED WELL: 167 ft. Depth(s) Groundwater Encountered (1) 129 ft. (2) ft. (3) ft. WELL'S STATIC WATER LEVEL 129 ft. below land surface measured on mo/day/yr. Pump test data: Well water was ft. after hours pumping gpm EST. YIELD gpm. Well water was ft. after hours pumping gpm Bore Hole Diameter 6 in. to 17.5 ft. and in. to ft. WELL WATER TO BE USED AS: Public water supply, Geothermal, Injection well, Domestic, Feedlot, Oil field water supply, Dewatering, Other (Specify below), Irrigation, Industrial, Domestic-lawn & garden, Monitoring well. Was a chemical/bacteriological sample submitted to Department? Yes No. If yes, mo/day/yr sample was submitted. Water well disinfected? Yes No

5 TYPE OF CASING USED: Steel, PVC, Other. CASING JOINTS: Glued, Clamped, Welded, Threaded. Casing diameter 2 in. to 1.37 ft., Diameter in. to ft., Diameter in. to ft. Casing height above land surface 20 in., Weight 70 lbs./ft., Wall thickness or gauge No. SCH. 40. TYPE OF SCREEN OR PERFORATION MATERIAL: Steel, Stainless Steel, Brass, Galvanized Steel, PVC, None used (open hole). SCREEN OR PERFORATION OPENINGS ARE: Continuous slot, Mill slot, Gauze wrapped, Torch cut, Drilled holes, None (open hole), Louvered shutter, Key punched, Wire wrapped, Saw cut, Other (specify). SCREEN-PERFORATED INTERVALS: From 137 ft. to 167 ft., From ft. to ft., From ft. to ft. GRAVEL PACK INTERVALS: From 133 ft. to 17.5 ft., From ft. to ft., From ft. to ft.

6 GROUT MATERIAL: Neat cement, Cement grout, Bentonite, Other. Grout Intervals: From 0 ft. to 133 ft., From ft. to ft., From ft. to ft. What is the nearest source of possible contamination: Septic tank, Lateral lines, Pit privy, Livestock pens, Insecticide storage, Other (specify below), Sewer lines, Cesspool, Sewage lagoon, Fuel storage, Abandoned water well, Watertight sewer lines, Seepage pit, Feedyard, Fertilizer storage, Oil well/gas well. Unknown. Direction from well Distance from well

Table with columns: FROM, TO, LITHOLOGIC LOG, FROM, TO, LITHO. LOG (cont.) or PLUGGING INTERVALS. Rows include: 0-103 Fine sand w/ seams of GH, 103-128 Silty sand, 128-140 clayey sand, 140-157 clay, 157-160 Fine sand, 160-164 Clay, 164-167 Fine sand, 167-175 Clay.

7 CONTRACTOR'S OR LANDOWNER'S CERTIFICATION: This water well was constructed, reconstructed, or plugged under my jurisdiction and was completed on (mo/day/year) and this record is true to the best of my knowledge and belief. Kansas Water Well Contractor's License No. 597. This Water Well Record was completed on (mo/day/year) 8-8-14 under the business name of CASCADE DRILLING L.P. by (signature)

INSTRUCTIONS: Use typewriter or ball point pen. PLEASE PRESS FIRMLY and PRINT clearly. Please fill in blanks and check the correct answers. Send three copies (white, blue, pink) to Kansas Department of Health and Environment, Bureau of Water, Geology Section, 1000 SW Jackson St., Suite 420, Topeka, Kansas 66612-1367. Telephone 785-296-5522. Send one copy to WATER WELL OWNER and retain one for your records. Include fee of \$5.00 for each constructed well. Visit us at http://www.kdheks.gov/waterwell/index.html.