

**WATER WELL PLUGGING RECORD Form WWC-5P**

KSA 82a-1212

ID NO.


N/A

**1 LOCATION OF WATER WELL:** Fraction 1/4 SW 1/4 NW 1/4 NE 1/4 Section Number 2 Township Number T 24 S Range Number 33  E  W  
 County: FINNEY

Street/Rural Address of Well Location: if unknown, distance & direction from nearest town or intersection: If at owner's address, check here  From the intersection of Cummings road & VFW road, 4/10 mile West, 1/10 mile North

**2 WATER WELL OWNER:** Brookover Feed Yard  
 RR#, St. Address, Box #: P.O. Box 917  
 City, State ZIP Code: Garden City Ks., 67846

**Global Positioning Systems (GPS) information:**  
 Latitude: 38.00125 (in decimal degrees)  
 Longitude: -100.90911 (in decimal degrees)  
 Elevation: \_\_\_\_\_  
 Datum:  WGS84,  NAD83,  NAD27  
 Collection Method:  
 GPS unit (Make/Model: Garmin eTrex 10)  
 Digital Map/Photo.  Topographic Map.  Land Survey  
 Est. Accuracy:  < 3 m.  3-5 m.  5-15 m.  > 15 m

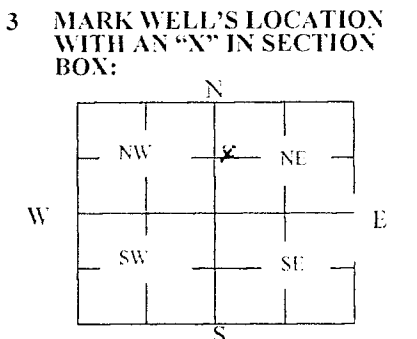

**4 DEPTH OF WELL** 220' ft.  
 WELL'S STATIC WATER LEVEL 132' ft  
 WELL WAS USED AS:  
 Domestic  Public Water Supply  Dewatering  
 Irrigation  Oil Field Water Supply  Monitoring  
 Feedlot  Domestic (Lawn & Garden)  Injection Well  
 Industrial  Air Conditioning  Other \_\_\_\_\_  
 Was a chemical/bacteriological sample submitted to Department? Yes  No

**5 TYPE OF BLANK CASING USED:**  
 Steel  RMP (SR)  Wrought  Fiberglass  Other (Specify below) \_\_\_\_\_  
 PVC  ABS  Asbestos-Cement  Concrete Tile \_\_\_\_\_  
 Blank casing diameter 6" in. Was casing pulled? Yes  No  If yes, how much 60"  
 Casing height above or below land surface Below 60" in.

**6 GROUT PLUG MATERIAL:**  Neat cement  Cement grout  Bentonite  Other \_\_\_\_\_  
 Grout Plug Intervals: From 10' ft. to 5' ft., From \_\_\_\_\_ ft. to \_\_\_\_\_ ft., From \_\_\_\_\_ to \_\_\_\_\_ ft.  
 What is the nearest source of possible contamination:  
 Septic tank  Seepage pit  Fuel Storage  Other (specify below) \_\_\_\_\_  
 Sewer lines  Pit privy  Fertilizer storage \_\_\_\_\_  
 Watertight sewer lines  Sewage lagoon  Insecticide storage \_\_\_\_\_  
 Lateral lines  Feedyard  Abandoned water well  Oil well/Gas well \_\_\_\_\_  
 Cess pool  Livestock pens  \_\_\_\_\_  
 Direction from well? Southwest  
 How many feet? Approx.400'

FROM	TO	PLUGGING MATERIALS	FROM	TO	PLUGGING MATERIALS
220'	130'	Chlorinated Road Sand	130'	126'	Bentonite Hole Plug
126'	10'	Oversized Rock with Clay Chunks	10'	5'	3,000 PSI Concrete
5'	0'	Cut of casing and Backfilled			

**7 CONTRACTOR'S OR LANDOWNER'S CERTIFICATION:** This water well was plugged under my jurisdiction and was completed on (mo/day/year) 2-13-2020 and this record is true to the best of my knowledge and belief. Kansas Water Well Contractor's License No. 145. This Water Well Record was completed on (mo/day/year) 2-18-2020 under the business name of Hydro Resources Mid Continent by (signature) Gary Clepper

**INSTRUCTIONS:** Use typewriter or ballpoint pen. Please press firmly and print clearly. Please fill in blanks, underline or circle the correct answers. Send top three copies to Kansas Department of Health and Environment, Bureau of Water, Geology Section, 1000 SW Jackson St., Ste. 420, Topeka, Kansas 66612-1367. Telephone: 785/296-5524. Send one to Water Well Owner and retain one for your records. Visit us at <http://www.kdheks.gov/waterwell/index.html>.

Check one:  White Copy  Blue Copy  Pink Copy