

# WATER WELL PLUGGING RECORD Form WWC-5P

KSA 82a-1212

ID NO.

N/A

1 LOCATION OF WATER WELL:	Fraction	Section Number	Township Number	Range Number
County: Finney	¼ SE ¼ SE ¼ SE ¼	3	T 24 S	33 <input type="checkbox"/> E <input checked="" type="checkbox"/> W

Street/Rural Address of Well Location; if unknown, distance & direction from nearest town or intersection: If at owner's address, check here ☐ From the intersection of West Jones &

Anderson Road approx. 60 yards North 10 yards West

## Global Positioning Systems (GPS) information:

Latitude: 37.99063 (in decimal degrees)

Longitude: -100.92022 (in decimal degrees)

Elevation:

Datum: ☐ WGS84, ☐ NAD83, ☒ NAD27

Collection Method:


☒ GPS unit (Make/Model: Garmin eTrex 10

☐ Digital Map/Photo, ☐ Topographic Map, ☐ Land Survey

Est. Accuracy: ☐ < 3 m. ☐ 3-5 m. ☐ 5-15 m. ☐ > 15 m

2 WATER WELL OWNER: Peterbilt of Garden City  
RR#, St. Address, Box #: P.O. Box 1866  
City, State ZIP Code: Garden City Ks., 67846

## 3 MARK WELL'S LOCATION WITH AN "X" IN SECTION BOX:

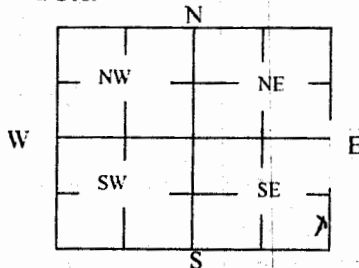

## 4 DEPTH OF WELL 287' ft.

WELL'S STATIC WATER LEVEL 138' ft

WELL WAS USED AS:

☒ Domestic  
☐ Irrigation  
☐ Feedlot  
☐ Industrial

☐ Public Water Supply  
☐ Oil Field Water Supply  
☐ Domestic (Lawn & Garden)  
☐ Air Conditioning

☐ Dewatering  
☐ Monitoring  
☐ Injection Well  
☐ Other

Was a chemical/bacteriological sample submitted to Department? Yes ☐ No ☒

## 5 TYPE OF BLANK CASING USED:

☐ Steel ☐ RMP (SR) ☐ Wrought ☐ Fiberglass ☐ Other (Specify below)  
☒ PVC ☐ ABS ☐ Asbestos-Cement ☐ Concrete Tile

Blank casing diameter 5" in. Was casing pulled? Yes ☒ No ☐ If yes, how much 72"

Casing height above or below land surface Below 72" in.

## 6 GROUT PLUG MATERIAL: ☐ Neat cement ☒ Cement grout ☒ Bentonite ☐ Other

Grout Plug Intervals: From 12' ft. to 6' ft., From 287' ft. to 12' ft., From to ft.

What is the nearest source of possible contamination:

☐ Septic tank ☐ Seepage pit ☐ Fuel Storage ☒ Other (specify below)  
☐ Sewer lines ☐ Pit privy ☐ Fertilizer storage  
☐ Watertight sewer lines ☐ Sewage lagoon ☐ Insecticide storage  
☐ Lateral lines ☐ Feedyard ☐ Abandoned water well  
☐ Cess pool ☐ Livestock pens ☐ Oil well/Gas well  
None Observed

Direction from well?

How many feet?

FROM	TO	PLUGGING MATERIALS	FROM	TO	PLUGGING MATERIALS
287'	12'	CHLORINATED BENTONITE	12'	6'	3,000 PSI CONCRETE
6'	0'	IN CULVERT VALVE PIT			

7 CONTRACTOR'S OR LANDOWNER'S CERTIFICATION: This water well was plugged under my jurisdiction and was completed on (mo/day/year) 9-23-2020 and this record is true to the best of my knowledge and belief. Kansas Water Well Contractor's License No. 145. This Water Well Record was completed on (mo/day/year) 9-28-2020 under the business name of Hydro Resources Mid Continent by (signature) Gary Clepper

INSTRUCTIONS: Use typewriter or ballpoint pen. Please press firmly and print clearly. Please fill in blanks, underline or circle the correct answers. Send top three copies to Kansas Department of Health and Environment, Bureau of Water, Geology Section, 1000 SW Jackson St., Ste. 420, Topeka, Kansas 66612-1367. Telephone: 785/296-5524. Send one to Water Well Owner and retain one for your records. Visit us at <http://www.kdheks.gov/waterwell/index.html>.

Check one: ☐ White Copy ☐ Blue Copy ☐ Pink Copy