USE TYPEWRITER OR BALL POINT PEN-PRESS FIRMLY, PRINT CLEARLY.

WATER WELL RECORD
KSA 82a-1201-1215

Kansas Department of Health and Environment-Division of Environment
(Water well Contractors)
Topeka, Kansas 66620

1. Location of well:	County	Fraction	Section number	Township number	Range number
	FINNEY	NE 1/4 SW 1/4 NE 1/4	21	T 24 S	R 34 E/W

2. Distance and direction from nearest town or city: From Holcomb River Bridge 2 south 3 ¼ west 3/4 north
Street address of well location if in city:

3. Owner of well: Circle Land & Cattle Co.
R.R. or street: (Williams #47)
City, state, zip code: Garden City, Ks. 67846

4. Locate with "X" in section below: Sketch map:

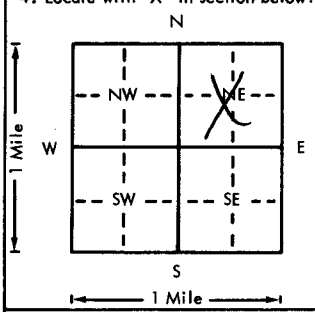

6. Bore hole dia. r26 in. Completion date 4-1-76
Well depth 385 ft.

7. ___ Cable tool ___ Rotary ___ Driven ___ Dug
___ Hollow rod ___ Jetted ___ Bored X Reverse rotary

8. Use: ___ Domestic ___ Public supply ___ Industry
X Irrigation ___ Air conditioning ___ Stock
___ Lawn ___ Oil field water ___ Other

9. Casing: Material steel Height: Above or below
Threaded ___ Welded X Surface 12 in.
RMP ___ PVC ___ Weight 36.87 lbs./ft.
Dia. 16 in. to 386 ft. depth Wall Thickness: inches or
Dia. ___ in. to ___ ft. depth gage No. .219 wall

5. Type and color of material	From	To
(Use a second sheet if needed)		

10. Screen: Manufacturer's name No Screen
Type ___ Dia. ___
Slot/gauze ___ Length ___
Set between Peri. 120-385 ft. and ___ ft.
___ ft. and ___ ft.
Gravel packed Yes Size range of material ⅛" Down

11. Static water level: mo./day/yr.
69 ft. below land surface Date 9-2-75

12. Pumping level below land surfaces:
81 ft. after 2 hrs. pumping 609 ~~600~~ g.p.m.
___ ft. after ___ hrs. pumping ___ g.p.m.
Estimated maximum yield 609 g.p.m.

13. Water sample submitted: mo./day/yr.
___ Yes X No Date ___

14. Well head completion:
___ Pitless adapter 12 Inches above grade

15. Well grouted? ~~yes~~
With: X Neat cement ___ Bentonite ___ Concrete
Depth: From 0 ft. to 10 ft.

16. Nearest source of possible contamination: N/A
ft. ___ Direction ___ Type ___
Well disinfected upon completion? ___ Yes X No

17. Pump: ___ Not installed
Manufacturer's name National Pump
Model number 12" HP 125 Volts ___
Length of drop pipe 220 ft. capacity 1000 g.p.m.?
Type:
___ Submersible X Turbine
___ Jet ___ Reciprocating
___ Centrifugal ___ Other

18. Elevation:

Topography:
X Hill
___ Slope
___ Upland
___ Valley

19. Remarks:

20. Water well contractor's certification:
This well was drilled under my jurisdiction and this report is true to the best of my knowledge and belief.
Winter Wilson Drilling 208
Business name License No.
Address P.O. Box A Garden City, Ks.
Signed [signature] Date 2-22-76
Authorized representative

Forward the white, blue and pink copies to the Department of Health and Environment

Form WWC-5

M1-1023

T 24 R 34 E/W Sec 21 1/4 NE 1/4 SW 1/4 NE 1/4

№ 5865

L. C. BURKETT, JR.
DRILLING COMPANY

(WE TEST THE EARTH)

Phone 948-4252

Drawer Y

SUNRAY, TEXAS

Section No. 21-24-34

#47

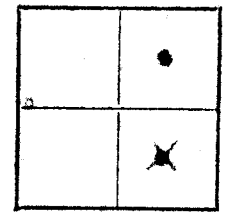

2564

12°

1-11-75

Test No. 18

County FINNEY

FROM	TO	DESCRIPTION	SAND
0	100	Surface Sand & Clay	
100	120	Fine to med to Coarse loose Sand [illegible]	[illegible]
120	140	med to Coarse loose Sand w/ clay [illegible]	14
140	160	med to Coarse loose clean Sand w/ clay	16
160	180	med to coarse loose clean Sand w/ clay [illegible]	17
180	200	Brown clay w/ Sand streaks	21
200	220	Brown soft clay w/ sand streaks	4
220	240	Coarse loose clean Sand w/ clay streaks sand & water	15
240	260	med to coarse loose clean sand w/ clay streaks	16
260	280	Coarse loose clean Sand sand & water	30
280	300	med to coarse tight to loose dirty to clean sand [illegible]	16
300	320	Coarse loose clean Sand w/ clay sand & water	18
320	340	Coarse loose Sand w/ clay strips sand & water	10
340	360	med to coarse loose Sand w/ clay sand & water	11
360	380	Fine to med to coarse loose clean sand	13
380	400	[illegible] sand [illegible]	3

[illegible]