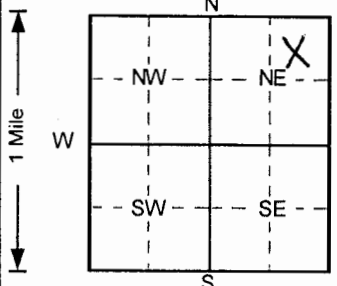


1 LOCATION OF WATER WELL: County: Finney	Fraction $\frac{1}{4}$ NE $\frac{1}{4}$ NE $\frac{1}{4}$	Section Number 3	Township Number T 24 S	Range Number R 34 E (W)
--	---	----------------------------	----------------------------------	--

Distance and direction from nearest town or city street address of well if located within city?

~1 mi N & 2 mi W of Holcomb on Hwy 50

2 WATER WELL OWNER: RR#, St. Address, Box # : NORTHERN NATURAL GAS City, State, ZIP Code : 451 S. COUNTRY ESTATES LIBERAL, KS 67901	Board of Agriculture, Division of Water Resources Application Number:
---	--

3 LOCATE WELL'S LOCATION WITH AN "X" IN SECTION BOX: 	4 DEPTH OF COMPLETED WELL 108 ft. ELEVATION: Depth(s) Groundwater Encountered 1. ft. 2. ft. 3. ft. WELL'S STATIC WATER LEVEL 101.77 ft. below land surface measured on mo/day/yr 5/16/2005 Pump test data: Well water was NA ft. after hours pumping gpm Est. Yield NA gpm: Well water was ft. after hours pumping gpm Bore Hole Diameter 8 in. to 108 ft. and in. to ft. WELL WATER TO BE USED AS: 5 Public water supply 8 Air conditioning 11 Injection well 1 Domestic 3 Feedlot 6 Oil field water supply 9 Dewatering 12 Other (Specify below) 2 Irrigation 4 Industrial 7 Lawn and garden only 10 Monitoring well Was a chemical/bacteriological sample submitted to Department? Yes.....No <input checked="" type="checkbox"/> ; If yes, mo/day/yr sample was submitted Water Well Disinfected? Yes No <input checked="" type="checkbox"/>
--	---

5 TYPE OF BLANK CASING USED: 1 Steel 3 RMP (SR) 5 Wrought iron 8 Concrete tile CASING JOINTS: Glued Clamped 2 PVC 4 ABS 6 Asbestos-Cement 9 Other (specify below) Welded Blank casing diameter 2 in. to 83 ft. Dia in. to ft. Dia in. to ft. Casing height above land surface 30 in., weight lbs./ft. Wall thickness or gauge No. Sch. 40 TYPE OF SCREEN OR PERFORATION MATERIAL 1 Steel 3 Stainless steel 5 Fiberglass 7 PVC 10 Asbestos-cement 2 Brass 4 Galvanized steel 6 Concrete tile 9 ABS 11 Other (specify) 12 None used (open hole) SCREEN OR PERFORATION OPENINGS ARE: 1 Continuous slot 3 Mill slot 5 Gauzed wrapped 8 Saw cut 11 None (open hole) 2 Louvered shutter 4 Key punched 6 Wire wrapped 9 Drilled holes 7 Torch cut 10 Other (specify) SCREEN-PERFORATED INTERVALS: From 83 ft. to 108 ft. From ft. to ft. From ft. to ft. From ft. to ft. GRAVEL PACK INTERVALS: From 80 ft. to 108 ft. From ft. to ft. From ft. to ft. From ft. to ft.
--

6 GROUT MATERIAL: 1 Neat cement 2 Cement grout 3 Bentonite 4 Other Grout Intervals: From 0 ft. to 3 ft. From 3 ft. to 80 ft. From ft. to ft. What is the nearest source of possible contamination: 1 Septic tank 4 Lateral lines 7 Pit privy 10 Livestock pens 14 Abandoned water well 2 Sewer lines 5 Cess pool 8 Sewage lagoon 11 Fuel storage 15 Oil well/Gas well 3 Watertight sewer lines 6 Seepage pit 9 Feedyard 12 Fertilizer storage 16 Other (specify below) 13 Insecticide storage Direction from well? How many feet? 0

FROM	TO	LITHOLOGIC LOG	FROM	TO	PLUGGING INTERVALS
0	0.2	Grass,	101	108	Clay, some sand and silt, Lt. Brown
0.2	13	Silt, trace sand, Brown grading to Lt. Yellowish			
13	18.5	Silt, trace to some clay, Lt. Yellowish Brown			
18.5	20.5	Clay, trace silt, Lt. Yellowish Brown			
20.5	32	Silt, trace sand and clay, Yellowish Brown			
32	36	Silt, some sand, Lt. Brown			
36	38.5	Sand, trace silt, Lt. Brown			
38.5	40.5	Clay, some sand, Brown			
40.5	45.5	Silt, some sand, Lt. Yellowish Brown			
45.5	54.5	Clay, trace to some sand and silt, Brown			
54.5	66	Silt, some clay, trace sand, Lt. Yellowish Brow			
66	73	Sand (f-c), damp, Lt. Yellowish Brown			
73	78	Silt, some sand, trace clay, Lt. Brown			MW32, Abovegrade
78	86	Clay, trace to some sand, Brown			Project Name: BM - NNG Holcomb Plant
86	101	Sand (vf-c), some silt, Brown			GeoCore # 1188, #

7 CONTRACTOR'S OR LANDOWNER'S CERTIFICATION: This water well was (1) constructed, (2) reconstructed, or (3) plugged under my jurisdiction and was completed on (mo/day/year) 4/30/2005 and this record is true to the best of my knowledge and belief. Kansas Water Well Contractor's License No. 527 This Water Well Record was completed on (mo/day/yr) 5/27/05 under the business name of GeoCore, Inc. by (signature) <i>Joe Bell</i>
--