

1 LOCATION OF WATER WELL:	Fraction	Section Number	Township Number	Range Number
County: <b>Finney</b>	<b>SW</b> $\frac{1}{4}$ <b>SW</b> $\frac{1}{4}$ <b>NW</b> $\frac{1}{4}$	<b>T 24 S</b>	<b>R 34 W</b>	<b>E 19</b>

Distance and direction from nearest town or city street address of well if located within city?

Land Appl. MAA - Farm Fields

T24S, R34W, Sec. 19

2 WATER WELL OWNER: **Tyson Foods**

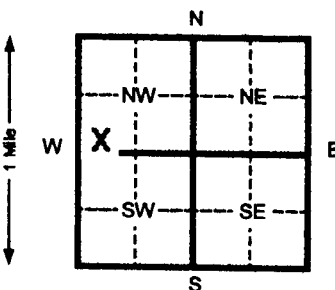
RR#, St. Address, Box # :

City, State, ZIP Code : **Garden City, Ks**

Board of Agriculture, Division of Water Resources

Application Number:

3 LOCATE WELL'S LOCATION WITH AN "X" IN SECTION BOX:

4 DEPTH OF COMPLETED WELL **225** ft. ELEVATION:

Depth(s) Groundwater Encountered 1 \_\_\_\_\_ ft. 2 \_\_\_\_\_ ft. 3 \_\_\_\_\_ ft.

WELL'S STATIC WATER LEVEL \_\_\_\_\_ ft. below land surface measured on mo/day/yr

Pump test data: Well water was \_\_\_\_\_ ft. after \_\_\_\_\_ hours pumping \_\_\_\_\_ gpm

Est. Yield \_\_\_\_\_ gpm: Well water was \_\_\_\_\_ ft. after \_\_\_\_\_ hours pumping \_\_\_\_\_ gpm

Bore Hole Diameter **8** in. to **229** ft. and \_\_\_\_\_ in. to \_\_\_\_\_ ft.

WELL WATER TO BE USED AS: 5 Public water supply 8 Air conditioning 11 Injection well

1 Domestic 3 Feed lot 6 Oil field water supply 9 Dewatering 12 Other (Specify below)

2 Irrigation 4 Industrial 7 Lawn and garden (domestic) **10** Monitoring wellWas a chemical/bacteriological sample submitted to Department? Yes \_\_\_\_\_ No **X** If yes, mo/day/yr sample was submittedWater Well Disinfected? Yes \_\_\_\_\_ No **X**

5 TYPE OF BLANK CASING USED:

1 Steel

3 RMP (SR)

5 Wrought Iron

8 Concrete tile

CASING JOINTS: Glued \_\_\_\_\_ Clamped \_\_\_\_\_

**2** PVC

4 ABS

6 Asbestos-Cement 9 Other (specify below)

Welded \_\_\_\_\_

7 Fiberglass

Threaded \_\_\_\_\_

Blank casing diameter **4** in. to **185** ft., Dia \_\_\_\_\_ in. to \_\_\_\_\_ ft., Dia \_\_\_\_\_ in. to \_\_\_\_\_ ft.Casing height above land surface **36** in., weight **2.071** lbs./ft. Wall thickness or gauge No. **.237**

TYPE OF SCREEN OR PERFORATION MATERIAL:

1 Steel

3 Stainless steel

5 Fiberglass

**7** PVC

10 Asbestos-cement

2 Brass

4 Galvanized steel

6 Concrete tile

8 RMP (SR)

11 Other (specify)

SCREEN OR PERFORATION OPENINGS ARE:

1 Continuous slot

3 Mill slot

5 Gauzed wrapped

**8** Saw cut

11 None (open hole)

2 Louvered shutter

4 Key punched

6 Wire wrapped

9 Drilled holes

SCREEN-PERFORATED INTERVALS: From **185** ft. to **225** ft. From \_\_\_\_\_ ft. to \_\_\_\_\_ ft.

10 Other (specify)

GRAVEL PACK INTERVALS: From **182** ft. to **225** ft. From \_\_\_\_\_ ft. to \_\_\_\_\_ ft.

6 GROUT MATERIAL:

1 Neat cement

**2** Cement grout

3 Bentonite

4 Other \_\_\_\_\_

Grout intervals From **0** ft. to **179** ft. From **179** ft. to **182** ft. From \_\_\_\_\_ ft. to \_\_\_\_\_ ft.

What is the nearest source of possible contamination:

1 Septic tank

4 Lateral lines

7 Pit privy

10 Livestock pens

14 Abandoned water well

2 Sewer lines

5 Cess pool

8 Sewage lagoon

11 Fuel storage

15 Oil well/ Gas well

3 Watertight sewer lines

6 Seepage pit

9 Feedyard

12 Fertilizer storage

16 Other (specify below)

13 Insecticide storage

**Contaminated site**

Direction from well?

How many feet?

FROM	TO	CODE	LITHOLOGIC LOG	FROM	TO	PLUGGING INTERVALS
0	7		Fine sand	193	195	Fine to some med sand
7	12		Fine to some med sand	195	200	Clay - blue grey shale
12	24		Med sand	200	202	Fine to some med sand
24	41		Clay	202	209	Clay & Blue Grey shale
41	49		Clay w/a few sd strks	209	210	Sand
49	55		Fine to some med sand w/clay	210	213	Clay - blue grey shale
			Strks	213	225	Fine to some med sand
55	65		Clay	225	226	Caliche
65	71		Clay w/a few sand strks	226	229	clay
71	88		Fine sand w/clay strks			
88	136		Clay & sandy clay			
136	186		Blue grey shale			
186	191		Fine to some med sand			
191	193		Clay - blue grey shale			

7 CONTRACTOR'S OR LANDOWNER'S CERTIFICATION: This water well was (1) constructed, (2) reconstructed, or (3) plugged under my jurisdiction and was completed on (mo/day/yr) **5-18-05**

and this record is true to the best of my knowledge and belief. Kansas

Water Well Contractor's License No. **554**This Water Well Record was completed on (mo/day/yr) **6-30-05**

under the business name of

**Woofert Pump & Well Inc.**

by (signature)

INSTRUCTIONS: Please fill in blanks and circle the correct answers. Send three copies to Kansas Department of Health and Environment, Bureau of Water, 1000 S W Jackson St., Ste. 420, Topeka, Kansas 66612-1387. Telephone: 913-296-5545. Send one to WATER WELL OWNER and retain one for your records.