

WATER WELL RECORD

Form WWC-5

Division of Water Resources App. No.


20,896

| | | | | |
|----------------------------------------------------|------------------------------|----------------------|------------------------|---------------------------------------------------------------------------------------|
| 1 LOCATION OF WATER WELL: County: FINNEY | Fraction ¼ SE ¼ NW ¼ SW ¼ | Section Number 33 | Township No. T 24 S | Range Number R 34 <input type="checkbox"/> E <input checked="" type="checkbox"/> W |
|----------------------------------------------------|------------------------------|----------------------|------------------------|---------------------------------------------------------------------------------------|

Street/Rural Address of Well Location; if unknown, distance & direction from nearest town or intersection: If at owner's address, check here .
HOLCOMB - 4 MILES SOUTH, 3 MILES WEST
1,718 FT. NORTH & 4,260 FT. WEST

Global Positioning System (GPS) information:
 Latitude: (in decimal degrees)
 Longitude: (in decimal degrees)
 Elevation:
 Datum: WGS 84, NAD 83, NAD 27
 Collection Method:
 GPS unit (Make/Model:)
 Digital Map/Photo, Topographic Map, Land Survey
 Est. Accuracy: <3 m, 3-5 m, 5-15 m, >15 m

2 WATER WELL OWNER: TYSON FRESH MEATS, INC.
 RR#, Street Address, Box #: 800 STEVENS PORT DRIVE
 City, State, ZIP Code : DAKOTA DUNES, S.D. 57049

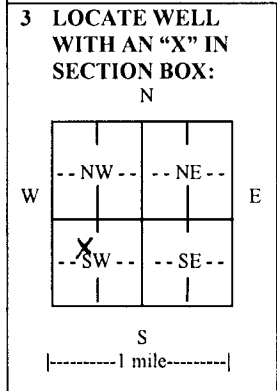

4 DEPTH OF COMPLETED WELL .430..... ft.
 Depth(s) Groundwater Encountered (1)..... ft. (2)..... ft. (3)..... ft.
WELL'S STATIC WATER LEVEL .270..... ft. below land surface measured on mo/day/yr. 4-18-14.....
 Pump test data: Well water was..... ft. after..... hours pumping..... gpm
 EST. YIELD..... gpm. Well water was..... ft. after..... hours pumping..... gpm
 Bore Hole Diameter .30..... in. to .430..... ft., and..... in. to..... ft.
WELL WATER TO BE USED AS: Public water supply Geothermal Injection well
 Domestic Feedlot Oil field water supply Dewatering Other (Specify below)
 Irrigation Industrial Domestic-lawn & garden Monitoring well
 Was a chemical/bacteriological sample submitted to Department? Yes No
 If yes, mo/day/yr sample was submitted.....
 Water well disinfected? Yes No

5 TYPE OF CASING USED: Steel PVC Other
CASING JOINTS: Glued Clamped Welded Threaded
 Casing diameter .16..... in. to .280..... ft., Diameter..... in. to..... ft., Diameter..... in. to..... ft.
 Casing height above land surface..... 12..... in., Weight 42.05..... lbs./ft., Wall thickness or gauge No. 250.....
TYPE OF SCREEN OR PERFORATION MATERIAL:
 Steel Stainless Steel PVC Other (Specify)
 Brass Galvanized Steel None used (open hole)
SCREEN OR PERFORATION OPENINGS ARE:
 Continuous slot Mill slot Gauze wrapped Torch cut Drilled holes None (open hole)
 Louvered shutter Key punched Wire wrapped Saw cut Other (specify)
SCREEN-PERFORATED INTERVALS: From .280..... ft. to .430..... ft., From..... ft. to..... ft.
 From..... ft. to..... ft., From..... ft. to..... ft.
GRAVEL PACK INTERVALS: From .20..... ft. to .205..... ft., From .265..... ft. to .430..... ft.
 From..... ft. to..... ft., From..... ft. to..... ft.

6 GROUT MATERIAL: Neat cement Cement grout Bentonite Other
 Grout Intervals: From .0..... ft. to .20..... ft., From .205..... ft. to .265..... ft., From..... ft. to..... ft.
What is the nearest source of possible contamination:
 Septic tank Lateral lines Pit privy Livestock pens Insecticide storage Other (specify below)
 Sewer lines Cesspool Sewage lagoon Fuel storage Abandoned water well
 Watertight sewer lines Seepage pit Feedyard Fertilizer storage Oil well/gas well N/A
 Direction from well Distance from well

| FROM | TO | LITHOLOGIC LOG | FROM | TO | LITHO. LOG (cont.) or PLUGGING INTERVALS |
|------|----|------------------|------|----|------------------------------------------|
| | | SEE ATTACHED LOG | | | |
| | | | | | |
| | | | | | |
| | | | | | |
| | | | | | |
| | | | | | |
| | | | | | |
| | | | | | |
| | | | | | |
| | | | | | |

7 CONTRACTOR'S OR LANDOWNER'S CERTIFICATION: This water well was constructed, reconstructed, or plugged under my jurisdiction and was completed on (mo/day/year) 4-18-14..... and this record is true to the best of my knowledge and belief.
 Kansas Water Well Contractor's License No. 208..... This Water Well Record was completed on (mo/day/year) 4-23-14.....
 under the business name of MINTER-WILSON DRILLING CO., INC..... by (signature) *Alan Keiser*.....

INSTRUCTIONS: Use typewriter or ball point pen. PLEASE PRESS FIRMLY and PRINT clearly. Please fill in blanks and check the correct answers. Send one copy to Kansas Department of Health and Environment, Bureau of Water, Geology Section, 1000 SW Jackson St., Suite 420, Topeka, Kansas 66612-1367. Telephone 785-296-5524. Send one copy to WATER WELL OWNER and retain one for your records. Include fee of \$5.00 for each constructed well. Visit us at <http://www.kdheks.gov/waterwell/index.html>

*The
Professionals*

MINTER-WILSON DRILLING CO.
INCORPORATED

Irrigation
and Domestic
Water Systems
Complete Installation
and Repairing

Phone 620-276-8269 • P.O. Box A • GARDEN CITY, KANSAS 67846

NAME TYSON FRESH MEATS, INC.
COUNTY FINNEY
DATE 3-13-14

LOCATION: SW 1/4 33-24-34 - DEERFIELD LANE & CRIST ROAD - 3-1/2 MILES EAST,
1/4 MILE NORTH & 1/4 MILE WEST
- NORTHWEST OF PIVOT BETWEEN 3 & 4 TOWERS

STATIC WATER LEVEL - 230 FT.

TEST # 2

0' TO 2' - TOP SOIL
2' TO 24' - BROWN SANDY CLAY
24' TO 155' - MEDIUM GRAVEL & STREAKS OF CLAY - 10%
155' TO 182' - FINE SAND
182' TO 280' - BLUE CLAY
280' TO 420' - MEDIUM GRAVEL
420' TO 440' - BROWN CLAY
440' TO 455' - SHALE