


2411010

MW-3

1 LOCATION OF WATER WELL: County: <u>Kearny</u>	Fraction <u>SE 1/4 NW 1/4 SW 1/4</u>	Section Number <u>11</u>	Township Number T <u>24</u> S	Range Number R <u>35</u> E <u>(W)</u>
--	---	-----------------------------	----------------------------------	--

Distance and direction from nearest town or city street address of well if located within city?
West 6th Street, Deerfield

2 WATER WELL OWNER: RR#, St. Address, Box # : City, State, ZIP Code	<u>Garden City Coop</u> <u>West 2nd Street</u> <u>Deerfield, KS 67838</u>	Board of Agriculture, Division of Water Resources Application Number:
---	---	--

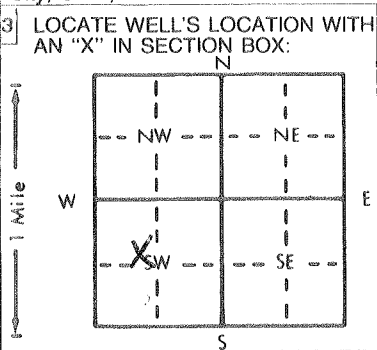

4 DEPTH OF COMPLETED WELL: <u>9</u> ft. ELEVATION:	Depth(s) Groundwater Encountered <u>1</u> ft. 2. ft. 3. ft.
WELL'S STATIC WATER LEVEL: <u>7</u> ft. below land surface measured on mo/day/yr	Pump test data: Well water was ft. after hours pumping gpm
Est. Yield gpm: Well water was ft. after hours pumping gpm	Bore Hole Diameter: <u>8</u> in. to ft., and in. to ft.
WELL WATER TO BE USED AS:	5 Public water supply 8 Air conditioning 11 Injection well
1 Domestic 3 Feedlot 6 Oil field water supply 9 Dewatering 12 Other (Specify below)	2 Irrigation 4 Industrial 7 Lawn and garden only <u>10 Monitoring well</u>
Was a chemical/bacteriological sample submitted to Department? Yes No <u>X</u> ; If yes, mo/day/yr sample was sub-	mitted
Water Well Disinfected? Yes No <u>X</u>	

5 TYPE OF BLANK CASING USED:	5 Wrought iron	8 Concrete tile	CASING JOINTS: Glued Clamped
1 Steel	3 RMP (SR)	6 Asbestos-Cement	9 Other (specify below)
<u>2 PVC</u>	4 ABS	7 Fiberglass	Welded
Blank casing diameter: <u>2</u> in. to ft., Dia in. to ft., Dia in. to ft.			Threaded
Casing height above land surface: <u>12</u> in., weight lbs./ft. Wall thickness or gauge No.			
TYPE OF SCREEN OR PERFORATION MATERIAL:	1 Steel	3 Stainless steel	5 Fiberglass
2 Brass	4 Galvanized steel	6 Concrete tile	7 PVC
SCREEN OR PERFORATION OPENINGS ARE:	1 Continuous slot	3 Mill slot	5 Gauzed wrapped
2 Louvered shutter	4 Key punched	7 Torch cut	8 Saw cut
SCREEN-PERFORATED INTERVALS: From ft. to ft., From ft. to ft.			9 Drilled holes
GRAVEL PACK INTERVALS: From ft. to ft., From ft. to ft.			10 Other (specify)
			11 None used (open hole)

6 GROUT MATERIAL:	1 Neat cement	2 Cement grout	3 Bentonite	4 Other
Grout Intervals: From ft. to ft., From ft. to ft., From ft. to ft.				
What is the nearest source of possible contamination:	1 Septic tank	4 Lateral lines	7 Pit privy	10 Livestock pens
	2 Sewer lines	5 Cess pool	8 Sewage lagoon	11 Fuel storage
	3 Watertight sewer lines	6 Seepage pit	9 Feedyard	12 Fertilizer storage
				13 Insecticide storage
Direction from well?				14 Abandoned water well
				15 Oil well/Gas well
				16 Other (specify below)

FROM	TO	LITHOLOGIC LOG	FROM	TO	PLUGGING INTERVALS
			<u>9</u>	<u>19</u>	<u>fill Bentonite</u>
Spoke w/ Don Taylor on 6/11/97 about form being turned in later.					

7 CONTRACTOR'S OR LANDOWNER'S CERTIFICATION: This water well was (1) constructed, (2) reconstructed, or (3) <u>plugged</u> under my jurisdiction and was completed on (mo/day/year) <u>5/3/96</u> and this record is true to the best of my knowledge and belief. Kansas Water Well Contractor's License No. <u>537</u> This Water Well Record was completed on (mo/day/yr) <u>6/9/97</u> under the business name of <u>GSI</u> by (signature) <u>Allison M. Jansen</u>
