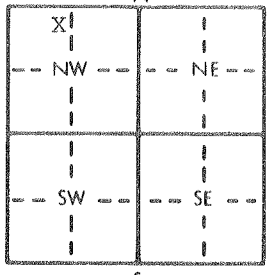


WATER WELL RECORD Form WWC-5 KSA 82a-1212

1 LOCATION OF WATER WELL: Fraction NE 1/4 NW 1/4 NW 1/4 Section Number I Township Number T 24 S Range Number R 35 EW
 County: Kearny
 Distance and direction from nearest town or city street address of well if located within city?

Approximately 1 1/2 miles north & approximately 1/2 mile east of Deerfield, Ks.

2 WATER WELL OWNER: The Garden City Company
 RR#, St. Address, Box # : P. O. Box 597 Board of Agriculture, Division of Water Resources
 City, State, ZIP Code : Garden City, Ks. 67846 Application Number: 7195-D1A

3 LOCATE WELL'S LOCATION WITH AN "X" IN SECTION BOX:

 4 DEPTH OF COMPLETED WELL: 416 ft. ELEVATION:
 Depth(s) Groundwater Encountered 1. 113 ft. 2. 205 ft. 3. 1678 ft.
 WELL'S STATIC WATER LEVEL 113 ft. below land surface measured on mo/day/yr 8-6-90
 Pump test data: Well water was 205 ft. after 4 hours pumping 1678 gpm
 Est. Yield 1650 gpm: Well water was ft. after hours pumping gpm
 Bore Hole Diameter .24 in. to 416 ft., and in. to ft.
 WELL WATER TO BE USED AS:
 5 Public water supply 8 Air conditioning 11 Injection well
 1 Domestic 3 Feedlot 6 Oil field water supply 9 Dewatering 12 Other (Specify below)
 2 Irrigation 4 Industrial 7 Lawn and garden only 10 Monitoring well
 Was a chemical/bacteriological sample submitted to Department? Yes.....No.....X.....; If yes, mo/day/yr sample was submitted
 Water Well Disinfected? Yes No X

5 TYPE OF BLANK CASING USED:
 1 Steel 3 RMP (SR) 5 Wrought iron 8 Concrete tile CASING JOINTS: Glued Clamped
 2 PVC 4 ABS 6 Asbestos-Cement 9 Other (specify below) Welded X
 7 Fiberglass Threaded

Blank casing diameter .16 in. to 416 ft., Dia . in. to . ft., Dia . in. to . ft.
 Casing height above land surface 12 in., weight 42.05 lbs./ft. Wall thickness or gauge No. 250

TYPE OF SCREEN OR PERFORATION MATERIAL:
 1 Steel 3 Stainless steel 5 Fiberglass 7 PVC 10 Asbestos-cement
 2 Brass 4 Galvanized steel 6 Concrete tile 8 RMP (SR) 11 Other (specify)
 12 None used (open hole)

SCREEN OR PERFORATION OPENINGS ARE:
 1 Continuous slot 3 Mill slot 5 Gauzed wrapped 8 Saw cut 11 None (open hole)
 2 Louvered shutter 4 Key punched 6 Wire wrapped 9 Drilled holes
 7 Torch cut 10 Other (specify)

SCREEN-PERFORATED INTERVALS: From 206 ft. to 246 ft., From 263 ft. to 303 ft.
 From 316 ft. to 416 ft., From ft. to ft.
 GRAVEL PACK INTERVALS: From 20 ft. to 416 ft., From ft. to ft.
 From ft. to ft., From ft. to ft.

6 GROUT MATERIAL: 1 Neat cement 2 Cement grout 3 Bentonite 4 Other
 Grout Intervals: From 0 ft. to 20 ft., From ft. to ft., From ft. to ft.


What is the nearest source of possible contamination:
 1 Septic tank 4 Lateral lines 7 Pit privy 10 Livestock pens 14 Abandoned water well
 2 Sewer lines 5 Cess pool 8 Sewage lagoon 11 Fuel storage 15 Oil well/Gas well
 3 Watertight sewer lines 6 Seepage pit 9 Feedyard 12 Fertilizer storage 16 Other (specify below)
 13 Insecticide storage

Direction from well? Southwest How many feet? 100

FROM	TO	LITHOLOGIC LOG	FROM	TO	PLUGGING INTERVALS
		See attached log			

7 CONTRACTOR'S OR LANDOWNER'S CERTIFICATION: This water well was (1) constructed, (2) reconstructed, or (3) plugged under my jurisdiction and was completed on (mo/day/year) 8-3-90 and this record is true to the best of my knowledge and belief. Kansas Water Well Contractor's License No. 145 This Water Well Record was completed on (mo/day/yr) August 9, 1990 under the business name of Henkle Drilling & Supply Co., Inc. by (signature) *Benny Richman*

INSTRUCTIONS: Use typewriter or ball point pen. PLEASE PRESS FIRMLY and PRINT clearly. Please fill in blanks, underline or circle the correct answers. Send top three copies to Kansas Department of Health and Environment, Bureau of Water, Topeka, Kansas 66620-7320. Telephone: 913-296-5545. Send one to WATER WELL OWNER and retain one for your records.

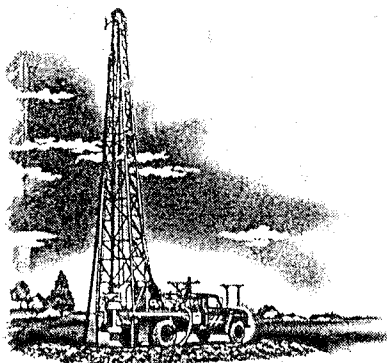

Henkle

DRILLING & SUPPLY CO., INC.

3795 W. JONES AVE.
316/277-2389
FAX/277-0224

P.O. Box 639
GARDEN CITY, KANSAS 67846

CUSTOMER'S NAME The Garden City Company DATE August 1, 1990
 STREET ADDRESS P. O. Box 597 TEST # 1 E. LOG Yes
 CITY & STATE Garden City, Ks. 67846 DRILLER Shelden
 COUNTY Kearny QUARTER NW SECTION 1 TOWNSHIP 24 RANGE 35

LOCATION 100' north east of old well

%	FOOTAGE			DESCRIPTION OF STRATA	STATIC WATER LEVEL: <u>83'</u>	
	From	Pay	To		Proposed Well Depth: <u>416'</u>	
	0		2	Top soil		
	2		43	Brown sandy clay		
	43		47	Sand fine to medium coarse		
	47		75	Gray clay		
	75		83	Brown clay		
	83		87	Sand fine to medium coarse		
	87		99	Brown clay		
40	99	36	135	Sand fine to small with some clay streaks		
60	135	28	163	Sand fine to medium coarse small to some medium gravel		
	163		172	Brown sandy clay		
60	172	58	230	Sand fine to medium coarse small gravel		
60	230	16	246	Sand fine to medium coarse small gravel with few cemented ledges		
	246		261	Brown sandy clay with some small sand streaks		
55	261	11	272	Sand fine to medium coarse		
50	272	17	289	Sand fine to medium coarse with some clay streaks & some lime rock ledges		
	289		294	Brown sandy clay		
45	294	10	304	Sand fine to medium		
	304		315	Brown sandy clay & lime rock with few small sand streaks		
50	315	9	324	Sand fine to medium drilled rough		
	324		333	Brown sandy clay		
55	333	39	372	Sand fine to medium coarse drilled loose in places		
75	372	41	413	Sand fine to medium coarse small brown & white rock drilled loose		
	413		422	Shale		
				Well depth = 416'		
				Set up east - Pit on south		