

WATER WELL RECORD Form WWC-5 KSA 82a-1212

1 LOCATION OF WATER WELL: Fraction Section Number Township Number Range Number
 COUNTY: 047 KEARNY NW 1/4 NE 1/4 SW 1/4 2 T 24 S R 35 W

Distance and direction from nearest town or city street address of well if located within city?
 1 MILE NORTH OF DEERFIELD

2 WATER WELL OWNER: SCHEUERMAN, CALVIN
 RR#, St. Address, Box #: P.O. BOX 231 Board of Agriculture, Division of Water Resources
 City, State, ZIP code: DEERFIELD, KS 67838- Application Number: 1203

3 LOCATE WELL'S LOCATION WITH AN "X" IN SECTION BOX: 4 DEPTH OF COMPLETED WELL 399 ELEVATION: 0
 Depth(s) Groundwater Encountered 1. 0 ft. 2. 0 ft. 3. 0 ft.

WELL'S STATIC WATER LEVEL 100 ft. below land surface measured on mo/day/yr 05/13/94
 Pump test data: Well water was 197 ft. after 1 hours pumping 1537 gpm
 Estimated Yield 1500 gpm: Well water was 0 ft. after 0 hours pumping 0 gpm
 Bore Hole Diameter 24 in. to 399 ft., and in. to 0 ft.
 WELL WATER TO BE USED AS: 02 IRRIGATION
 Was a chemical/bacteriological sample submitted to department? No;
 If yes, mo/day/yr sample was submitted Water well disinfected? Yes

5 TYPE OF BLANK CASING USED: 01 STEEL CASING JOINTS: WELDED
 Blank casing diameter 16 in. to 399 ft., Dia in. to 0 ft., Dia in. to 0 ft.
 Casing height above land surface 12 in., weight 42 lbs/ft. Wall thickness or gauge No. .25
 TYPE OF SCREEN OR PERFORATION MATERIAL: 01 STEEL
 SCREEN OR PERFORATION OPENINGS ARE: 06 WIRE WRAPPED

SCREEN PERFORATED INTERVALS: From 235 ft. to 255 ft., From 0 ft. to 0 ft.
 From 276 ft. to 396 ft., From 0 ft. to 0 ft.
 GRAVEL PACK INTERVALS: From 20 ft. to 399 ft., From 0 ft. to 0 ft.
 From 0 ft. to 0 ft., From 0 ft. to 0 ft.

6 GROUT MATERIAL 03 BENTONITE
 Grout Intervals: From 0 ft. to 20 ft., From 0 ft. to 0 ft., From 0 ft. to 0 ft.
 What is the nearest source of possible contamination: 14 ABAND. WELL
 Direction from well? EAST How many feet? 290

FROM	TO	LITHOLOGIC LOG	FROM	TO	PLUGGING INTERVALS
0	2	02 SILT			
2	25	04 SANDY CLAY 05 SAND			
25	31	01 CLAY 04 SANDY CLAY			
31	36	04 SANDY CLAY			
36	43	04 SANDY CLAY 01 CLAY			
43	51	07 FINE SAND 08 MEDIUM SAND 04 SANDY CLAY			
51	61	01 CLAY 04 SANDY CLAY 17 SAND & GRAVL			
61	79	04 SANDY CLAY 05 SAND			
79	85	07 FINE SAND 08 MEDIUM SAND 04 SANDY CLAY			
85	103	05 SAND 11 GRAVEL 04 SANDY CLAY			

7 CONTRACTOR'S OR LANDOWNER'S CERTIFICATION: This water well was Constructed under my jurisdiction and was completed on (mo/day/year) 05/12/94 and this record is true to the best of my knowledge and belief. Kansas Water Well Contractor's License No. 145 This Water Well Record was completed on (mo/day/yr) 05/16/94 under the business name of HENKLE DRILLING & SUPPLY by (signature)

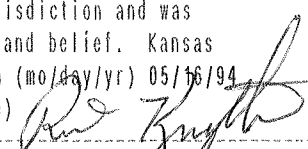
(Continued)

WATER WELL RECORD Form WWC-5 KSA 82a-1212

1 LOCATION OF WATER WELL:	Fraction	Section Number	Township Number	Range Number
COUNTY: 047 KEARNY	NW 1/4 NE 1/4 SW 1/4	2	T 24 S	R 35 W

2 WATER WELL OWNER:	SCHEUERMAN, CALVIN	Board of Agriculture, Division of Water Resources
RR#, St. Address, Box # :	P.O. BOX 231	Application Number: 1203
City, State, ZIP code :	DEERFIELD, KS 67838-	

FROM	TO	LITHOLOGIC LOG
103	133	04 SANDY CLAY 05 SAND
133	159	01 CLAY
159	169	07 FINE SAND 08 MEDIUM SAND 04 SANDY CLAY
169	174	01 CLAY
174	186	07 FINE SAND 08 MEDIUM SAND 01 CLAY
186	201	01 CLAY 07 FINE SAND
201	210	01 CLAY 04 SANDY CLAY
210	215	04 SANDY CLAY 01 CLAY
215	235	04 SANDY CLAY
235	242	05 SAND 11 GRAVEL
242	255	07 FINE SAND 08 MEDIUM SAND 04 SANDY CLAY
255	265	07 FINE SAND 08 MEDIUM SAND 04 SANDY CLAY
265	273	04 SANDY CLAY 05 SAND
273	279	07 FINE SAND 08 MEDIUM SAND 04 SANDY CLAY
279	290	07 FINE SAND 08 MEDIUM SAND 04 SANDY CLAY
290	310	07 FINE SAND 08 MEDIUM SAND 04 SANDY CLAY
310	324	07 FINE SAND 08 MEDIUM SAND 14 MED GRAVEL
324	355	07 FINE SAND 08 MEDIUM SAND 01 CLAY
355	363	04 SANDY CLAY 05 SAND
363	396	05 SAND 11 GRAVEL 28 ROCK
396	401	04 SANDY CLAY 05 SAND

7 CONTRACTOR'S OR LANDOWNER'S CERTIFICATION: This water well was Constructed under my jurisdiction and was completed on (mo/day/year) 05/12/94 and this record is true to the best of my knowledge and belief. Kansas Water Well Contractor's License No. 145 This Water Well Record was completed on (mo/day/yr) 05/16/94 under the business name of HENKLE DRILLING & SUPPLY	by (signature) 
--	--