


1 LOCATION OF WATER WELL: Fraction UW 1/4 NE 1/4 SW 1/4 Section Number 11 Township Number T 24 S Range Number R 35 EW
 County: KEARNY

Distance and direction from nearest town or city street address of well if located within city?
N OF SIXTH - EAST OF MAIN ST - DEERFIELD KS

2 WATER WELL OWNER: GARDEN CITY CO OP INC Board of Agriculture, Division of Water Resources
 RR#, St. Address, Box #: EAST 6TH ST DEERFIELD KS 67838 Application Number:
 City, State, ZIP Code

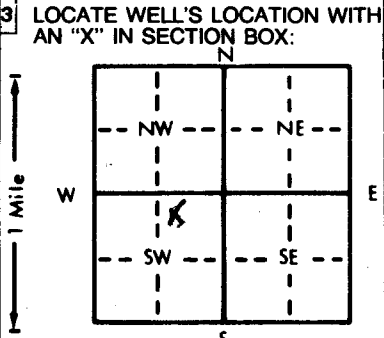

4 DEPTH OF COMPLETED WELL: 13.5 ft. ELEVATION: 2943.85 B.O.H.T.
 Depth(s) Groundwater Encountered 1. 7.8 ft. 2. _____ ft. 3. _____ ft.
 WELL'S STATIC WATER LEVEL 4.73 ft. below land surface measured on mo/day/yr 05-28-93
 Pump test data: Well water was NA ft. after _____ hours pumping _____ gpm
 Est. Yield NA gpm: Well water was _____ ft. after _____ hours pumping _____ gpm
 Bore Hole Diameter 7.5 in. to 14 ft., and _____ in. to _____ ft.
 WELL WATER TO BE USED AS:
 1 Domestic 3 Feedlot 6 Oil field water supply 9 Dewatering 12 Other (Specify below)
 2 Irrigation 4 Industrial 7 Lawn and garden only 10 Monitoring well
 Was a chemical/bacteriological sample submitted to Department? Yes _____ No X; If yes, mo/day/yr sample was submitted _____
 Water Well Disinfected? Yes _____ No X

5 TYPE OF BLANK CASING USED:
 1 Steel 3 RMP (SR) 5 Wrought iron 8 Concrete tile CASING JOINTS: Glued _____ Clamped _____
 2 PVC 4 ABS 6 Asbestos-Cement 9 Other (specify below) Welded _____
 7 Fiberglass Threaded X
 Blank casing diameter 2 in. to 3.5 ft., Dia _____ in. to _____ ft., Dia _____ in. to _____ ft.
 Casing height above land surface FLUSH MOUNT in., weight _____ SEA 40 lbs./ft. Wall thickness or gauge No. _____
 TYPE OF SCREEN OR PERFORATION MATERIAL:
 1 Steel 3 Stainless steel 5 Fiberglass 7 PVC 10 Asbestos-cement
 2 Brass 4 Galvanized steel 6 Concrete tile 8 RMP (SR) 11 Other (specify) _____
 9 ABS 12 None used (open hole)
 SCREEN OR PERFORATION OPENINGS ARE:
 1 Continuous slot 3 Mill slot 5 Gauzed wrapped 8 Saw cut 11 None (open hole)
 2 Louvered shutter 4 Key punched 6 Wire wrapped 9 Drilled holes
 7 Torch cut 10 Other (specify) _____
 SCREEN-PERFORATED INTERVALS: From 3.5 ft. to 13.5 ft., From _____ ft. to _____ ft.
 From _____ ft. to _____ ft., From _____ ft. to _____ ft.
~~SAND~~ GRAVEL PACK INTERVALS: From 3.5 ft. to 14 ft., From _____ ft. to _____ ft.
 From _____ ft. to _____ ft., From _____ ft. to _____ ft.

6 GROUT MATERIAL: 1 Neat cement 2 Cement grout 3 Bentonite 4 Other _____
 Grout Intervals: From 4 ft. to 3.5 ft., From _____ ft. to _____ ft., From _____ ft. to _____ ft.
 What is the nearest source of possible contamination:
 1 Septic tank 4 Lateral lines 7 Pit privy 10 Livestock pens 14 Abandoned water well
 2 Sewer lines 5 Cess pool 8 Sewage lagoon 11 Fuel storage 15 Oil well/Gas well
 3 Watertight sewer lines 6 Seepage pit 9 Feedyard 12 Fertilizer storage 16 Other (specify below)
 13 Insecticide storage CONTAMINATE SITE
 Direction from well? _____ How many feet? _____

FROM	TO	LITHOLOGIC LOG	FROM	TO	PLUGGING INTERVALS
<u>6L</u>	<u>1</u>	<u>FILL</u>	<u>6L</u>	<u>1.4</u>	<u>CONCRETE</u>
<u>1</u>	<u>7.8</u>	<u>SILTY CLAY BRN TR.SP.</u>	<u>1.4</u>	<u>3.5</u>	<u>BENTONITE</u>
<u>7.8</u>	<u>14</u>	<u>LENSE OF SD/BD. CLAY</u>	<u>3.5</u>	<u>14</u>	<u>SAND PRCK.</u>
		<u>SAT AT 7.8</u>			

7 CONTRACTOR'S OR LANDOWNER'S CERTIFICATION: This water well was (1) constructed, (2) reconstructed, or (3) plugged under my jurisdiction and was completed on (mo/day/year) 05-14-93 and this record is true to the best of my knowledge and belief. Kansas Water Well Contractor's License No. 479 This Water Well Record was completed on (mo/day/yr) 06-16-93 under the business name of EBBERTS DRILLING by (signature) Debra M. Ebbert

INSTRUCTIONS: Use typewriter or ball point pen. PLEASE PRESS FIRMLY and PRINT clearly. Please fill in blanks, underline or circle the correct answers. Send top three copies to Kansas Department of Health and Environment, Bureau of Water, Topeka, Kansas 66620-0001. Telephone: 913-296-5545. Send one to WATER WELL OWNER and retain one for your records.

LATE FILE TRF DON TAYLER 06-10-93 8:36 AM