


1 LOCATION OF WATER WELL: County: **KEARNY** Fraction: **NW 1/4 NE 1/4 SW 1/4** Section Number: **11** Township Number: **T 24 S** Range Number: **R 35 EW**

Distance and direction from nearest town or city street address of well if located within city?
APPROX 40' E of #1 - SHOP DRIVE WAY N OF 6TH - DEER FIELD KS

2 WATER WELL OWNER: **GARDEN CITY CDDP INC** RR#, St. Address, Box #: **EAST 6TH ST DEER FIED KS 67838** Board of Agriculture, Division of Water Resources
 City, State, ZIP Code: **KS 67838** Application Number:

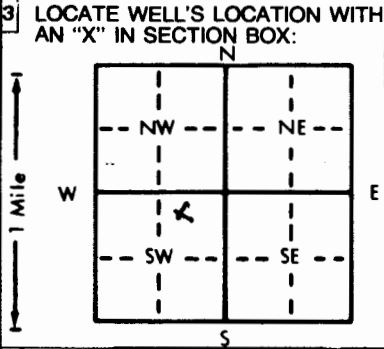

4 DEPTH OF COMPLETED WELL: **8** ft. ELEVATION: **NA**
 Depth(s) Groundwater Encountered 1. **6.5** ft. 2. **---** ft. 3. **---** ft.
 WELL'S STATIC WATER LEVEL: **5** ft. below land surface measured on mo/day/yr **05-13-93**
 Pump test data: Well water was **NA** ft. after **---** hours pumping **---** gpm
 Est. Yield: **NA** gpm; Well water was **---** ft. after **---** hours pumping **---** gpm
 Bore Hole Diameter: **7.5** in. to **8** ft., and **---** in. to **---** ft.
 WELL WATER TO BE USED AS:
 1 Domestic 3 Feedlot 6 Oil field water supply 9 Dewatering
 2 Irrigation 4 Industrial 7 Lawn and garden only 10 Monitoring well **SOIL SAMP. TEST WELL**
 5 Public water supply 8 Air conditioning 11 Injection well
 12 Other (Specify below) **SOIL SAMP. TEST WELL**
 Was a chemical/bacteriological sample submitted to Department? Yes No ; If yes, mo/day/yr sample was submitted **---**
 Water Well Disinfected? Yes No

5 TYPE OF BLANK CASING USED: **NONE**
 1 Steel 3 RMP (SR) 5 Wrought iron 8 Concrete tile
 2 PVC 4 ABS 6 Asbestos-Cement 9 Other (specify below)
 7 Fiberglass CASING JOINTS: Glued Clamped
 Welded Threaded
 Blank casing diameter: **NA** in. to **---** ft., Dia. **---** in. to **---** ft., Dia. **---** in. to **---** ft.
 Casing height above land surface: **NA** in., weight **---** lbs./ft. Wall thickness or gauge No. **---**
 TYPE OF SCREEN OR PERFORATION MATERIAL: **NA**
 1 Steel 3 Stainless steel 5 Fiberglass 7 PVC 10 Asbestos-cement
 2 Brass 4 Galvanized steel 6 Concrete tile 8 RMP (SR) 11 Other (specify)
 12 None used (open hole)
 SCREEN OR PERFORATION OPENINGS ARE: **NA**
 1 Continuous slot 3 Mill slot 5 Gauzed wrapped 8 Saw cut 11 None (open hole)
 2 Louvered shutter 4 Key punched 6 Wire wrapped 9 Drilled holes
 7 Torch cut 10 Other (specify)
 SCREEN-PERFORATED INTERVALS: From **NA** ft. to **---** ft., From **---** ft. to **---** ft.
SAND GRAVEL PACK INTERVALS: From **5** ft. to **6.5** ft., From **---** ft. to **---** ft.
 From **---** ft. to **---** ft., From **---** ft. to **---** ft.

6 GROUT MATERIAL: **#3** Neat cement 2 Cement grout 3 Bentonite 4 Other
 Grout Intervals: From **1** ft. to **5** ft., From **110** ft. to **---** ft., From **---** ft. to **---** ft.
 What is the nearest source of possible contamination:
 1 Septic tank 4 Lateral lines 7 Pit privy 10 Livestock pens 14 Abandoned water well
 2 Sewer lines 5 Cess pool 8 Sewage lagoon 11 Fuel storage 15 Oil well/Gas well
 3 Watertight sewer lines 6 Seepage pit 9 Feedyard 12 Fertilizer storage 16 Other (specify below) **IN CONTAMINATED SITE**
 13 Insecticide storage

Direction from well? **---** How many feet? **---**

FROM	TO	LITHOLOGIC LOG	FROM	TO	PLUGGING INTERVALS
0	0.65	CONCRETE			
0.65	2	SAND FILL			
2	6.5	SILTY CLAY STRONG DDOR ↑			
6.5	8	SAND / WATER ↓			

7 CONTRACTOR'S OR LANDOWNER'S CERTIFICATION: This water well was (1) constructed, (2) reconstructed, or (3) plugged under my jurisdiction and was completed on (mo/day/year) **05-13-93** and this record is true to the best of my knowledge and belief. Kansas Water Well Contractor's License No. **477** This Water Well Record was completed on (mo/day/yr) **05-19-93** under the business name of **EBBERTS DRILLING** by (signature) *August M. Ebberts*

INSTRUCTIONS: Use typewriter or ball point pen. PLEASE PRESS FIRMLY and PRINT clearly. Please fill in blanks, underline or circle the correct answers. Send top three copies to Kansas Department of Health and Environment, Bureau of Water, Topeka, Kansas 66620-0001. Telephone: 913-296-5545. Send one to WATER WELL OWNER and retain one for your records.