


WATER WELL RECORD Form WWC-5 KSA 82a-1212

1 LOCATION OF WATER WELL: \* Fraction : Section Number : Township Number : Range Number  
 COUNTY: 047 KEARNEY SE 1/4 NW 1/4 SW 1/4 : 11 : T 24 S : R 35 W

Distance and direction from nearest town or city street address of well if located within city?  
 WEST 6TH STREET DEERFIELD, KS 67838-

2 WATER WELL OWNER: GARDEN CITY COOP  
 AR#, St. Address, Box #: P.O. BOX 838 Board of Agriculture, Division of Water Resources  
 City, State, ZIP code : GARDEN CITY, KS 67846- Application Number:

3 LOCATE WELL'S LOCATION WITH AN "X" IN SECTION BOX: 4 DEPTH OF COMPLETED WELL 9 ELEVATION: 2946  
 Depth(s) Groundwater Encountered 1. 7 ft. 2. 0 ft. 3. 0 ft.

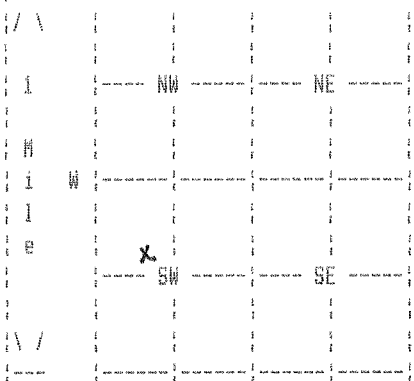

WELL'S STATIC WATER LEVEL 7 ft. below land surface measured on mo/day/yr 05/07/91  
 Pump test data: Well water was 0 ft. after 0 hours pumping 0 gpm;  
 Estimated Yield 0 gpm; Well water was 0 ft. after 0 hours pumping 0 gpm;  
 Bore Hole Diameter 8 in. to 10 ft., and in. to 0 ft.  
 WELL WATER TO BE USED AS: 10 MONITORING  
 Was a chemical/bacteriological sample submitted to department? No ;  
 If yes, mo/day/yr sample was submitted Water well disinfected? No

5 TYPE OF BLANK CASING USED: 02 PVC CASING JOINTS: THREADED  
 Blank casing diameter 2 in. to 9 ft., Dia in. to 0 ft., Dia in. to 0 ft.  
 Casing height above land surface 12 in., weight 1 lbs/ft. Wall thickness or gauge No. 0.154  
 TYPE OF SCREEN OR PERFORATION MATERIAL: 07 PVC  
 SCREEN OR PERFORATION OPENINGS ARE: 03 MILL SLOT

SCREEN PERFORATED INTERVALS: From 4 ft. to 9 ft., From 0 ft. to 0 ft.  
 From 0 ft. to 0 ft., From 0 ft. to 0 ft.  
 GRAVEL PACK INTERVALS: From 3 ft. to 10 ft., From 0 ft. to 0 ft.  
 From 0 ft. to 0 ft., From 0 ft. to 0 ft.

6 GROUT MATERIAL 02 CEMENT GROUT  
 Grout Intervals: From 0 ft. to 3 ft., From 0 ft. to 0 ft., From 0 ft. to 0 ft.  
 What is the nearest source of possible contamination: NONE OBSERVED  
 Direction from well? How many feet? 0

| FROM | TO | LITHOLOGIC LOG | FROM | TO | PLUGGING INTERVALS  |
|------|----|----------------|------|----|---|
| 0    | 7  | 01 CLAY        |      |    | *1,652' North and<br>4,568' west of the<br>Southeast corner of<br>11-24-35 Kearny Co. |
| 7    | 10 | 03 SILTY CLAY  |      |    |   |

7 CONTRACTOR'S OR LANDOWNER'S CERTIFICATION: This water well was Constructed under my jurisdiction and was completed on (mo/day/year) 05/07/91 and this record is true to the best of my knowledge and belief. Kansas Water Well Contractor's License No. 145 This Water Well Record was completed on (mo/day/yr) 07/30/91 under the business name of HENKLE DRILLING & SUPPLY by (signature) Douglas B. Henkle