


1 LOCATION OF WATER WELL: Fraction  $\frac{1}{4}$  NW  $\frac{1}{4}$  NW  $\frac{1}{4}$  Section Number 24 Township Number T 24 S Range Number R 35 E/W

Distance and direction from nearest town or city street address of well if located within city?

From Deerfield -  $1\frac{1}{2}$  Mi. SE

2 WATER WELL OWNER: Bob Glunt  
 RR#, St. Address, Box #: Box 131  
 City, State, ZIP Code: Holcomb, Kansas 67851  
 Board of Agriculture, Division of Water Resources  
 Application Number:

3 LOCATE WELL'S LOCATION WITH AN "X" IN SECTION BOX: 4 DEPTH OF COMPLETED WELL: 320 ft. ELEVATION:

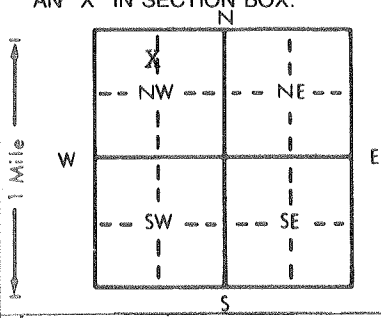

Depth(s) Groundwater Encountered 1. . . . . ft. 2. . . . . ft. 3. . . . . ft.  
 WELL'S STATIC WATER LEVEL . . . 50. . . . . ft. below land surface measured on mo/day/yr . . . 6-6-88 . . . . .  
 Pump test data: Well water was . . . . . ft. after . . . . . hours pumping . . . . . gpm  
 Est. Yield . . . . . gpm: Well water was . . . . . ft. after . . . . . hours pumping . . . . . gpm  
 Bore Hole Diameter: .10-5/8.in. to . . . . . 320 . . . . . ft., and . . . . . in. to . . . . . ft.  
 WELL WATER TO BE USED AS: 5 Public water supply 8 Air conditioning 11 Injection well  
 ① Domestic 3 Feedlot 6 Oil field water supply 9 Dewatering 12 Other (Specify below)  
 2 Irrigation 4 Industrial 7 Lawn and garden only 10 Observation well . . . . .  
 Was a chemical/bacteriological sample submitted to Department? Yes. . . . . No.  . . . . .; If yes, mo/day/yr sample was sub-  
 mitted Water Well Disinfected? Yes  No

5 TYPE OF BLANK CASING USED: 5 Wrought iron 8 Concrete tile CASING JOINTS: Glued  . . . . . Clamped . . . . .  
 1 Steel 3 RMP (SR) 6 Asbestos-Cement 9 Other (specify below) Welded . . . . .  
 ② PVC 4 ABS 7 Fiberglass Threaded . . . . .

Blank casing diameter . . . 6 . . . . . in. to . . . . . 280 . . . . . ft., Dia . . . . . in. to . . . . . ft., Dia . . . . . in. to . . . . . ft.  
 Casing height above land surface . . . 12 . . . . . in., weight . . . 3.99 . . . . . lbs./ft. Wall thickness or gauge No. . . ~~XXX~~ SDR21 . . . . .

TYPE OF SCREEN OR PERFORATION MATERIAL: ⑦ PVC 10 Asbestos-cement  
 1 Steel 3 Stainless steel 5 Fiberglass 8 RMP (SR) 11 Other (specify) . . . . .  
 2 Brass 4 Galvanized steel 6 Concrete tile 9 ABS 12 None used (open hole)

SCREEN OR PERFORATION OPENINGS ARE: 5 Gauzed wrapped ⑧ Saw cut 11 None (open hole)  
 1 Continuous slot 3 Mill slot 6 Wire wrapped 9 Drilled holes  
 2 Louvered shutter 4 Key punched 7 Torch cut 10 Other (specify) . . . . .

SCREEN-PERFORATED INTERVALS: From . . . . . 280 . . . . . ft. to . . . . . 320 . . . . . ft., From . . . . . ft. to . . . . . ft.  
 From . . . . . ft. to . . . . . ft., From . . . . . ft. to . . . . . ft.  
 GRAVEL PACK INTERVALS: From . . . . . 20 . . . . . ft. to . . . . . 320 . . . . . ft., From . . . . . ft. to . . . . . ft.  
 From . . . . . ft. to . . . . . ft., From . . . . . ft. to . . . . . ft.

6 GROUT MATERIAL: 1 Neat cement ② Cement grout 3 Bentonite 4 Other . . . . .  
 Grout Intervals: From . . . . . 0 . . . . . ft. to . . . . . 20 . . . . . ft., From . . . . . ft. to . . . . . ft., From . . . . . ft. to . . . . . ft.

What is the nearest source of possible contamination:  
 1 Septic tank 4 Lateral lines 7 Pit privy 10 Livestock pens 14 Abandoned water well  
 2 Sewer lines 5 Cess pool 8 Sewage lagoon 11 Fuel storage 15 Oil well/Gas well  
 3 Watertight sewer lines 6 Seepage pit 9 Feedyard 12 Fertilizer storage 16 Other (specify below)  
 13 Insecticide storage . . . . . NA . . . . .

Direction from well? How many feet?

FROM	TO	LITHOLOGIC LOG	FROM	TO	LITHOLOGIC LOG
		See attached log			

7 CONTRACTOR'S OR LANDOWNER'S CERTIFICATION: This water well was ① constructed, (2) reconstructed, or (3) plugged under my jurisdiction and was completed on (mo/day/year) . . . . . 6-6-88 . . . . . and this record is true to the best of my knowledge and belief. Kansas Water Well Contractor's License No. . . . . 208 . . . . . This Water Well Record was completed on (mo/day/yr) . . . 8-26-88 . . . . . under the business name of Minter-Wilson Drilling Co., Inc. by (signature) *Nora Keller*

sonals

# MINTER-WILSON DRILLING CO.

INCORPORATED

Irrigation  
and Domestic  
Water Systems  
Complete Installation  
and Repairing

Phone 276-8269 • P.O. Box A • GARDEN CITY, KANSAS 67846

Bob Glunt

Kearny Co.

3-22-88

Location: NW 24-24-~~25~~ 35

From Deerfield bridge 1/8 mile East

1 mile South 3/4 mile East 1/4 mile So.

Static water level 38

## Test #1

0 2 Top soil  
2 18 Brown clay  
18 52 Fine to medium sand & gravel (LOOSE)  
52 56 Brown sandy clay  
56 71 Fine to medium sand & gravel  
71 78 Brown sandy clay  
78 94 Fine to medium sand & gravel 15% Clay  
94 119 Fine to medium sand & gravel (Loose)  
119 129 Brown sandy clay  
129 148 Fine to medium sand & gravel (Loose)  
148 171 Brown sandy clay  
171 180 Blue clay (Tight)  
180 194 Fine to medium sand & gravel  
194 202 Brown sandy clay  
202 212 Fine to medium sand & gravel, small strip of clay  
212 228 Brown sandy clay  
228 244 Brown sandy clay, White rock mixed, hard  
244 268 Brown clay, sticky  
268 317 Fine to medium sand & gravel, small  
Yellow rock  
372 380 Yellow clay