


1 LOCATION OF WATER WELL: Fraction Section Number Township Number Range Number
 County: Kearny NW ¼ NE ¼ SW ¼ 11 24 35 EW

Distance and direction from nearest town or city street address of well if located within city?
 103 E. 6th, Deerfield

2 WATER WELL OWNER: Garden City Coop
 RR #, St. Address, Box #: PO Box 838
 City, State, ZIP Code: Garden City, KS 67846
 Board of Agriculture, Division of Water Resources
 Application Number:

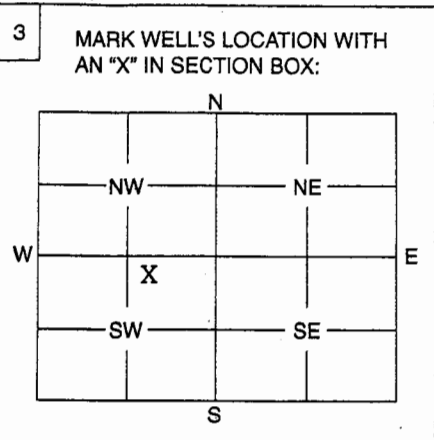

4 DEPTH OF WELL 13 ft.
 WELL'S STATIC WATER LEVEL ..n/a..... ft.
 WELL WAS USED AS:
 1 Domestic 2 Irrigation 3 Feedlot 4 Industrial 5 Public Water Supply 6 Oil Field Water Supply 7 Domestic (Lawn & Garden) 8 Air Conditioning 9 Dewatering 10 Monitoring Well 11 Injection Well 12 Other

Was a chemical / bacteriological sample submitted to Department? Yes No...X.....
 If yes, mo/day/yr sample was submitted

Water Well Disinfected: Yes No...X.....

5 TYPE OF BLANK CASING USED:
 1 Steel 2 PVC 3 RMP (SR) 4 ABS 5 Wrought 6 Asbestos-Cement 7 Fiberglass 8 Concrete Tile 9 Other (Specify below)
 Blank casing diameter 4 in. Was casing pulled? Yes X No
 Casing height above or below land surface n/a in. Excavated to 16.5' If yes, how much 13

6 GROUT PLUG MATERIAL: 1 Neat cement 2 Cement grout 3 Bentonite 4 Other
 Grout Plug Intervals: From 0 ft. to 13 ft., From ft. to ft., From to ft.
 What is the nearest source of possible contamination:
 1 Septic tank 2 Sewer lines 3 Watertight sewer lines 4 Lateral lines 5 Cess pool 6 Seepage pit 7 Pit privy 8 Sewage lagoon 9 Feedyard 10 Livestock pens 11 Fuel storage 12 Fertilizer storage 13 Insecticide storage 14 Abandoned water well 15 Oil well/Gas well 16 Other (specify below)

Direction from well? How many feet?

FROM	TO	PLUGGING MATERIALS
0	13	Filled casing with bentonite chips. Well casing removed while excavating contaminated soil to 16.5' to remediate area. Well was within excavated area.

VOBW-1

KDHE Project Code U6 026 11791
 GeoCore #1173

7 CONTRACTOR'S OF LANDOWNER'S CERTIFICATION: This water well was plugged under my jurisdiction and was completed on (mo/day/year) 3/29/2005 and this record is true to the best of my knowledge and belief. Kansas Water Well Contractor's License No. 527 This Water Well Record was completed on (mo/day/year) 4/11/2005 under the business name of GeoCore Inc. by (signature) Dola Hoff

INSTRUCTIONS: Use typewriter or ball point pen. Please press firmly and print clearly. Please fill in blanks, underline or circle the correct answers. Send top three copies to Kansas Department of Health and Environment, Bureau of Water, Geology Section, 1000 SW Jackson St., Ste. 420, Topeka, Kansas 66612-1367. Telephone: 785/296-5522. Send one to Water Well Owner and retain one for your records.