

CORRECTION(S) TO WATER WELL RECORD (WWC-5)

(to rectify lacking or incorrect information)

Location listed as:

Section-Township-Range: 21-24-35

Fraction (1/4 1/4 1/4): _____

County: Kearny

Location changed to:

21-245-35W

SE NE NW

Other changes: Initial statements: _____

Changed to: _____

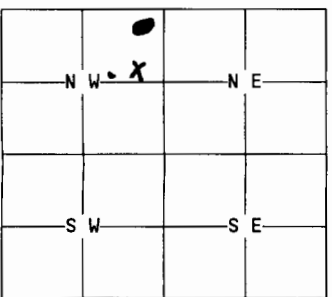
Comments: _____

verification method: Written & legal descriptions, position on plat map,
other well by same owner in same section, and Deerfield 1:24,000
topo. map. initials: DRL date: 10/20/2005

1	LOCATION OF WATER WELL: County: Kearny	Fraction 1/4 1/4 1/4	Section Number 21	Township Number 24	Range Number 35
---	--------------------------------------------------	-------------------------	-----------------------------	------------------------------	---------------------------

Distance and direction from nearest town or city street address of well if located within city?
Approx - 5 1/2 MILE SOUTH WEST of Deerfield on County Rd. V 23

2	WATER WELL OWNER: Larry Christiansen P.O. Box 285 Deerfield, Ks. 67838	RR#, St. Address, Box #: City, State, ZIP Code :	Board of Agriculture, Division of Water Resources Application Number: 2,500
---	----------------------------------------------------------------------------------------	-----------------------------------------------------	---------------------------------------------------------------------------------------

3	MARK WELL'S LOCATION WITH AN "X" IN SECTION BOX: N  S	4	DEPTH OF WELL.....ft. WELL'S STATIC WATER LEVEL.....ft. WELL WAS USED AS: 2. Irrigation 1 Domestic 5 Public Water Supply 9 Dewatering 2 Irrigation 6 Oil Field Water Supply 10 Monitoring Well 3 Feedlot 7 Lawn and Garden Only 11 Injection Well 4 Industrial 8 Air Conditioning 12 Other..... Was a chemical/bacteriological sample submitted to Department? Yes....No X .. If yes, mo/day/yr sample was submitted..... Water Well Disinfected: Yes. X .. No.....
---	---	---	---

5	TYPE OF BLANK CASING USED: 1- Steel <input checked="" type="checkbox"/> Steel 3 RMP (SR) 5 Wrought 7 Fiberglass 9 Other (specify below) <input type="checkbox"/> PVC 4 ABS 6 Asbestos-Cement 8 Concrete Tile Blank casing diameter.....in. Was casing pulled? Yes..... No... X .. If yes, how much..... Casing height <u>above</u> or below land surface..... 24in.
---	---

6	GROUT PLUG MATERIAL: 1 Neat cement 2 Cement grout <input checked="" type="checkbox"/> Bentonite 4 Other..... Grout Plug Intervals: From.....ft. to.....ft., From.....ft. to.....ft., From..... to.....ft. What is the nearest source of possible contamination: 1 Septic tank 6 Seepage pit 11 Fuel storage 16 Other (specify below) 2 Sewer lines 7 Pit privy 12 Fertilizer storage 3 Watertight sewer lines 8 Sewage lagoon 13 Insecticide storage Irrigation Well 4 Lateral lines 9 Feedyard 14 Abandoned water well 5 Cess Pool 10 Livestock pens 15 Oil well/Gas well Direction from well? North How many feet? 100
---	---

FROM	TO	PLUGGING MATERIALS
0	5	Backfill
5	25	Cement
25	35	Bentonite
35	75	Pea Gravel
75	100	Clay
100	130	Sand

7	CONTRACTOR'S OR LANDOWNER'S CERTIFICATION: This water well was plugged under my jurisdiction and was completed on (mo/day/year) Oct. 3, 2005 ... and this record is true to the best of my knowledge and belief. Kansas Water Well Contractor's License No. This Water Well Record was completed on (mo/day/year) 10-3-2005 ... under the business name of Larry Christiansen by (signature) <i>Larry Christiansen</i>
---	---

INSTRUCTIONS: Use typewriter or ball point pen. Please press firmly and print clearly. Please fill in blanks, underline or circle the correct answers. Send top three copies to Kansas Department of Health and Environment, Bureau of Water, Topeka, Kansas 66620-0001. Telephone: 913/296-3565. Send one to Water Well Owner and retain one for your records.