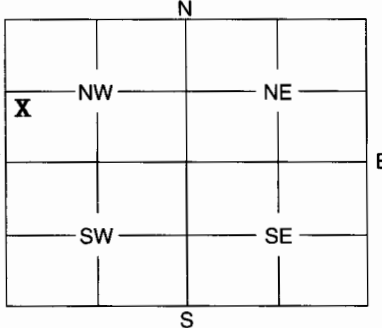


1 LOCATION OF WATER WELL: County: Kearny	Fraction NW ¼ SW ¼ NW ¼	Section Number 27	Township Number 24	Range Number 35
--	-----------------------------------	-----------------------------	------------------------------	---------------------------

Distance and direction from nearest town or city street address of well if located within city? **From Southeast Corner of Lakin 6 miles east, 3,551 ft. north & 5,160 ft. west**

2 WATER WELL OWNER: Suntera Farms	RR #, St. Address, Box #: 2443 Road 160	Board of Agriculture, Division of Water Resources
City, State, ZIP Code: Holcomb, Kansas 67851	Application Number: KE32	

3 MARK WELL'S LOCATION WITH AN "X" IN SECTION BOX:	4 DEPTH OF WELL 58 ft.	WELL'S STATIC WATER LEVEL 37 ft.
	WELL WAS USED AS: 1 Domestic 5 Public Water Supply 9 Dewatering 2 Irrigation 6 Oil Field Water Supply 10 Monitoring Well 3 Feedlot 7 Domestic (Lawn & Garden) 11 Injection Well 4 Industrial 8 Air Conditioning 12 Other	
Was a chemical / bacteriological sample submitted to Department? Yes No X If yes, mo/day/yr sample was submitted		
Water Well Disinfected: Yes X No		

5 TYPE OF BLANK CASING USED:	1 Steel 3 RMP (SR) 5 Wrought 7 Fiberglass 9 Other (Specify below) 2 PVC 4 ABS 6 Asbestos-Cement 8 Concrete Tile
Blank casing diameter 1.6 in.	Was casing pulled? Yes X No If yes, how much 5 Ft.
Casing height above or below land surface 60 in.	below

6 GROUT PLUG MATERIAL:	1 Neat cement 2 Cement grout 3 Bentonite 4 Other
Grout Plug Intervals: From 5 ft. to 58 ft.,	From ft. to ft., From to ft.
What is the nearest source of possible contamination:	
1 Septic tank 6 Seepage pit 11 Fuel storage 16 Other (specify below) 2 Sewer lines 7 Pit privy 12 Fertilizer storage 3 Watertight sewer lines 8 Sewage lagoon 13 Insecticide storage 4 Lateral lines 9 Feedyard 14 Abandoned water well N/A 5 Cess pool 10 Livestock pens 15 Oil well/Gas well	
Direction from well?	How many feet?

FROM	TO	PLUGGING MATERIALS
0	5	Top soil
5	58	Cement grout

7 CONTRACTOR'S OF LANDOWNER'S CERTIFICATION: This water well was plugged under my jurisdiction and was completed on (mo/day/year) 2-27-08 and this record is true to the best of my knowledge and belief. Kansas Water Well Contractor's License No. 208 This Water Well Record was completed on (mo/day/year) 2-28-08 under the business name of Minter-Wilson Drilling Co., Inc. by (signature) <i>Nora Keller</i>

INSTRUCTIONS: Use typewriter or ball point pen. Please press firmly and print clearly. Please fill in blanks, underline or circle the correct answers. Send top three copies to Kansas Department of Health and Environment, Bureau of Water, Geology Section, 1000 SW Jackson St., Ste. 420, Topeka, Kansas 66612-1367. Telephone: 785/296-5522. Send one to Water Well Owner and retain one for your records.