


USE TYPEWRITER OR BALL POINT PEN-PRESS FIRMLY, PRINT CLEARLY.

WATER WELL RECORD
KSA 82a-1201-1215

Kansas Department of Health and Environment-Division of Environment
(Water well Contractors)
Topeka, Kansas 66620

1. Location of well:		County Kearny	Fraction NW 1/4 NW 1/4 NW 1/4	Section number 2	Township number T 24 S R 35	Range number 35	E/W
2. Distance and direction from nearest town or city: 1 1/2 N. of Deerfield Street address of well location if in city:				3. Owner of well: Calvin Scheuerman R.R. or street: Deerfield, KS City, state, zip code:			
4. Locate with "X" in section below:			Sketch map:		6. Bore hole dia. 26 in. Completion date 8-31-76 Well depth 395 ft.		
					7. <input type="checkbox"/> Cable tool <input type="checkbox"/> Rotary <input type="checkbox"/> Driven <input type="checkbox"/> Dug <input type="checkbox"/> Hollow rod <input type="checkbox"/> Jetted <input type="checkbox"/> Bored <input checked="" type="checkbox"/> Reverse rotary		
5. Type and color of material			From	To	8. Use: <input type="checkbox"/> Domestic <input type="checkbox"/> Public supply <input type="checkbox"/> Industry <input checked="" type="checkbox"/> Irrigation <input type="checkbox"/> Air conditioning <input type="checkbox"/> Stock <input type="checkbox"/> Lawn <input type="checkbox"/> Oil field water <input type="checkbox"/> Other		
See attachment					9. Casing: Material Steel Height Above or below Threaded <input type="checkbox"/> Welded <input checked="" type="checkbox"/> Surface 12 in. RMP <input type="checkbox"/> PVC <input type="checkbox"/> Weight 36 lbs./ft. Dia. 16 in. to 395 ft. depth Wall Thickness: inches or Dia. <input type="checkbox"/> in. to <input type="checkbox"/> ft. depth gage No. 219		
					10. Screen: Manufacturer's name Brown Type Louvered Dia. 16" Slot/gauze 1/8 Length 115 Set between 395 ft. and 280 ft. ft. and <input type="checkbox"/> ft. Gravel pack? Yes Size range of material 1/4 x 1/8		
					11. Static water level: <input type="checkbox"/> mo./day/yr. 140 ft. below land surface Date 8-31-76		
					12. Pumping level below land surfaces: 215 ft. after <input type="checkbox"/> hrs. pumping 1600 g.p.m. <input type="checkbox"/> ft. after <input type="checkbox"/> hrs. pumping <input type="checkbox"/> g.p.m. Estimated maximum yield <input type="checkbox"/> g.p.m.		
					13. Water sample submitted: <input type="checkbox"/> mo./day/yr. <input type="checkbox"/> Yes <input checked="" type="checkbox"/> No Date <input type="checkbox"/>		
					14. Well head completion: <input type="checkbox"/> Pitless adapter 12 Inches above grade		
					15. Well grouted? Yes With: <input type="checkbox"/> Neat cement <input checked="" type="checkbox"/> Bentonite <input type="checkbox"/> Concrete Depth: From 0 ft. to 10 ft.		
					16. Nearest source of possible contamination: None observed ft. <input type="checkbox"/> Direction <input type="checkbox"/> Type <input type="checkbox"/> Well disinfected upon completion? <input type="checkbox"/> Yes <input checked="" type="checkbox"/> No		
					17. Pump: <input checked="" type="checkbox"/> Not installed Manufacturer's name <input type="checkbox"/> Model number <input type="checkbox"/> HP <input type="checkbox"/> Volts <input type="checkbox"/> Length of drop pipe <input type="checkbox"/> ft. capacity <input type="checkbox"/> g.p.m. Type: <input type="checkbox"/> Submersible <input type="checkbox"/> Turbine <input type="checkbox"/> Jet <input type="checkbox"/> Reciprocating <input type="checkbox"/> Centrifugal <input type="checkbox"/> Other		
			(Use a second sheet if needed)				
18. Elevation: Flat Topography: <input type="checkbox"/> Hill <input type="checkbox"/> Slope <input type="checkbox"/> Upland <input type="checkbox"/> Valley		19. Remarks:		20. Water well contractor's certification: This well was drilled under my jurisdiction and this report is true to the best of my knowledge and belief. Henkle Drig. & Supply 145 Business name License No. <input type="checkbox"/> Address Box 639 Garden City, KS Signed C. L. Bothwell Date 8-13-76 Authorized representative			

2
4
3
5
m
Sec
2
1/4
1/4
1/4

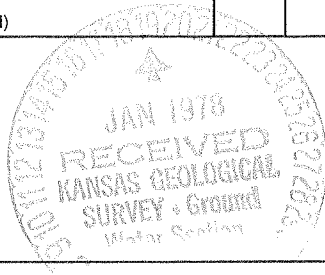

Forward the white, blue and pink copies to the Department of Health and Environment

Form WWC-5

DRILLERS TEST LOG

CUSTOMERS NAME Calvin Scheuerman DATE 8-23-76
 STREET ADDRESS _____ TEST # 1 E. Log 400'
 CITY & STATE Deerfield, KS DRILLER Rector
 COUNTY Kearny QUARTER NW SECTION 2 TOWNSHIP 24 RANGE 35
 LOCATION N.W. corner of 1/4

%	DRILLED FOOTAGE			WELL LOCATION	
	From	Pay	To	Description of Strata	Static Water Level Proposed Well Depth
	0		4	Top soil	
	4		10	Fine sand	
	10		60	Brown clay and few small sand sts.	
	60		80	Brown clay and caliche	
	80		100	Sand fine med. coarse, med. small gravel and brown sandy clay	
	100		135	Brown clay (murky)	
	135		138	Sand fine med. coarse and med. small gravel	
	138		141	Blue clay and coarse sand sts.	
	141		172	Blue clay (murky)	
50	172	22	194	Sand fine med. coarse and small gravel	
	194		216	Brown clay and caliche	
55	216	5	221	Sand fine med. coarse and small gravel, used lots of water	
	221		225	Brown clay	
55	225	6	235	Sand fine med. coarse and few med. small gravel, loose, used water	
	235		238	Brown clay and sand sts.	
40	238	8	246	Sand and gravel and small clay sts.	
60	246	34	280	Sand fine med. coarse and small gravel, loose, used lots of water, very few clay sts.	
	280		290	Brown clay	
60	290	14	304	Sand fine med. coarse and small gravel, loose, used lots of water	
	304		327	Brown clay	
70	327	23	350	Sand fine med. coarse, small gravel and some small white and tan rock, loose, used lots of water (good)	
60	350	6	356	Sand fine med. coarse, med. small gravel and brown sandy clay	
75	356	36	392	Sand fine med. coarse, small gravel and small white and tan rock, loose, used lots of water, good	
	392		395	Brown clay and soapstone	
	395		400	Shale	
		154			
				TOTAL DEPTH OF WELL 395 FT.	
				Face northeast; dig pit on the southeast	

GARDEN CITY, KANSAS HENKLE DRILLING & SUPPLY CO., INC. SUBLETTE, KANSAS
 PHONE 276-3278 IRRIGATION HEADQUARTERS PHONE 675-4311

TEST HOLES*****STOCK WELLS*****IRRIGATION AND INDUSTRIAL WELLS*****