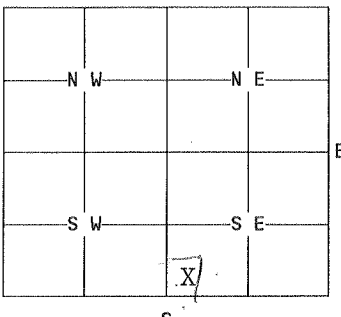


1	LOCATION OF WATER WELL: County: KEARNY	Fraction SW ^W _{1/4} SE _{1/4} SE _{1/4}	Section Number 23	Township Number 24	Range Number 35 ✓ WELL # 1
---	---	--	----------------------	-----------------------	-------------------------------

Distance and direction from nearest town or city street address of well if located within city?
2 MILES SOUTH OF DEERFIELD

2 WATER WELL OWNER: ROBERT GLUNT
RR#, St. Address, Box #: R.R. 1 BOX 131 Board of Agriculture, Division of Water Resources
City, State, ZIP Code : HOLCOMB, KANSAS 67851 Application Number:

3	MARK WELL'S LOCATION WITH AN "X" IN SECTION BOX: N  S	4	DEPTH OF WELL...40.....ft. WELL'S STATIC WATER LEVEL...DRY.....ft. WELL WAS USED AS: 2 <ul style="list-style-type: none"> <input checked="" type="checkbox"/> 1 Domestic <input checked="" type="checkbox"/> 2 Irrigation <input type="checkbox"/> 3 Feedlot <input type="checkbox"/> 4 Industrial <input type="checkbox"/> 5 Public Water Supply <input type="checkbox"/> 6 Oil Field Water Supply <input type="checkbox"/> 7 Lawn and Garden Only <input type="checkbox"/> 8 Air Conditioning <input type="checkbox"/> 9 Dewatering <input type="checkbox"/> 10 Monitoring Well <input type="checkbox"/> 11 Injection Well <input type="checkbox"/> 12 Other..... Was a chemical/bacteriological sample submitted to Department? Yes....No.... If yes, mo/day/yr sample was submitted..... Water Well Disinfected: Yes..... No...X..
---	---	---	---

5 TYPE OF BLANK CASING USED: 1
 1 Steel 3 RMP (SR) 5 Wrought 7 Fiberglass 9 Other (specify below)
 2 PVC 4 ABS 6 Asbestos-Cement 8 Concrete Tile

Blank casing diameter...24...in. Was casing pulled? Yes..... No..X... If yes, how much.....
 Casing height above or below land surface...36.....in.

6 GROUT PLUG MATERIAL: 1 Neat cement 2 Cement grout 3 Bentonite 4 Other.....

Grout Plug Intervals: From...6...ft. to...3...ft., From.....ft. toft., From..... to.....ft.

What is the nearest source of possible contamination: 14
 1 Septic tank 6 Seepage pit 11 Fuel storage 16 Other (specify below)
 2 Sewer lines 7 Pit privy 12 Fertilizer storage

Direction from well? ...SOUTH..... How many feet? ..500.....

FROM	TO	PLUGGING MATERIALS
40	6	SAND
6	3	CEMENT
3	0	TOPSOIL

7 CONTRACTOR'S OR LANDOWNER'S CERTIFICATION: This water well was plugged under my jurisdiction and was completed on (mo/day/year)...2-11-95..... and this record is true to the best of my knowledge and belief. Kansas Water Well Contractor's License No. This Water Well Record was completed on (mo/day/year) ...2-14-95..... under the business name of

by (signature) *Robert Glunt*

INSTRUCTIONS: Use typewriter or ball point pen. Please press firmly and print clearly. Please fill in blanks, underline or circle the correct answers. Send top three copies to Kansas Department of Health and Environment, Bureau of Water, Topeka, Kansas 66620-0001. Telephone: 913/296-3565. Send one to Water Well Owner and retain one for your records.