

1	LOCATION OF WATER WELL: County: KEARNY	Fraction SW 1/4 SW 1/4 NE 1/4	Section Number 12	Township Number 24	Range Number 35 <i>W</i>
---	---	----------------------------------	----------------------	-----------------------	-----------------------------

Distance and direction from nearest town or city street address of well if located within city?


1 MILE EAST DEERFIELD

2 WATER WELL OWNER: ROBERT KATZ

RR#, St. Address, Box #: ROUTE 1 BOX 100
City, State, ZIP Code : DEERFIELD, KS. 67838

Board of Agriculture, Division of Water Resources
Application Number:

3 MARK WELL'S LOCATION WITH AN "X" IN SECTION BOX:

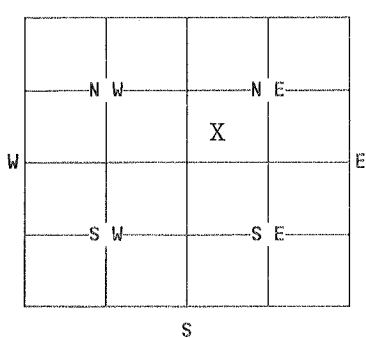

4 DEPTH OF WELL: 29 ft.

WELL'S STATIC WATER LEVEL: 25-5.3.5 ft.

WELL WAS USED AS: 1

- 1 Domestic
- 2 Irrigation
- 3 Feedlot
- 4 Industrial
- 5 Public Water Supply
- 6 Oil Field Water Supply
- 7 Lawn and Garden Only
- 8 Air Conditioning
- 9 Dewatering
- 10 Monitoring Well
- 11 Injection Well
- 12 Other.....

Was a chemical/bacteriological sample submitted to Department? Yes....No....
If yes, mo/day/yr sample was submitted.....

Water Well Disinfected: Yes...... No.....

5 TYPE OF BLANK CASING USED: 1

- 1 Steel
- 2 PVC
- 3 RMP (SR)
- 4 ABS
- 5 Wrought
- 6 Asbestos-Cement
- 7 Fiberglass
- 8 Concrete Tile
- 9 Other (specify below)

Blank casing diameter: 5 in. Was casing pulled? Yes..... No..... If yes, how much.....
Casing height above or below land surface: 36 in.

6 GROUT PLUG MATERIAL: 1 Neat cement 2 Cement grout 3 Bentonite 4 Other.....

Grout Plug Intervals: From 14 ft. to 6 ft., From.....ft. toft., From..... to.....ft.

What is the nearest source of possible contamination: 1

- 1 Septic tank
- 2 Sewer lines
- 3 Watertight sewer lines
- 4 Lateral lines
- 5 Cess Pool
- 6 Seepage pit
- 7 Pit privy
- 8 Sewage lagoon
- 9 Feedyard
- 10 Livestock pens
- 11 Fuel storage
- 12 Fertilizer storage
- 13 Insecticide storage
- 14 Abandoned water well
- 15 Oil well/Gas well
- 16 Other (specify below)

Direction from well? South How many feet? 1000

FROM	TO	PLUGGING MATERIALS
29	25.5	SAND
25.5	14	SUBSIOL/ CLAY
14	6	CEMENT
6	0	TOPSIOL

7 CONTRACTOR'S OR LANDOWNER'S CERTIFICATION: This water well was plugged under my jurisdiction and was completed on (mo/day/year)..... and this record is true to the best of my knowledge and belief. Kansas Water Well Contractor's License No. This Water Well Record was completed on (mo/day/year)..... under the business name of by (signature) Robert F. Katz

INSTRUCTIONS: Use typewriter or ball point pen. Please press firmly and print clearly. Please fill in blanks, underline or circle the correct answers. Send top three copies to Kansas Department of Health and Environment, Bureau of Water, Topeka, Kansas 66620-0001. Telephone: 913/296-3565. Send one to Water Well Owner and retain one for your records.