


1 LOCATION OF WATER WELL: Fraction SW 1/4 SW 1/4 SW 1/4 Section Number 17 Township Number T 24 S Range Number R 36 E/W
 County: Kearny
 Distance and direction from nearest town or city street address of well if located within city?

2 WATER WELL OWNER: Harold Loeppke
 RR#, St. Address, Box # : 504 Bopp Blvd. Board of Agriculture, Division of Water Resources
 City, State, ZIP Code : Lakin, Ks. 67860 Application Number:

3 LOCATE WELL'S LOCATION WITH AN "X" IN SECTION BOX:

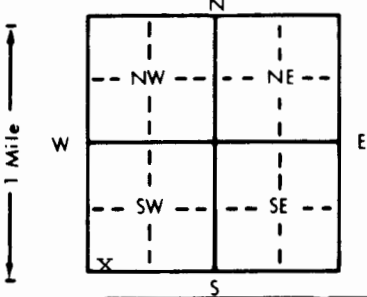

4 DEPTH OF COMPLETED WELL... 164 ft. ELEVATION:
 Depth(s) Groundwater Encountered 1. ft. 2. ft. 3. ft.
 WELL'S STATIC WATER LEVEL... 140 ft. below land surface measured on mo/day/yr... 5-31-96
 Pump test data: Well water was ft. after hours pumping gpm
 Est. Yield... 11 gpm: Well water was ft. after hours pumping gpm
 Bore Hole Diameter... 10 in. to 164 ft., and in. to ft.
 WELL WATER TO BE USED AS: 5 Public water supply 8 Air conditioning 11 Injection well
 1 Domestic 3 Feedlot 6 Oil field water supply 9 Dewatering Other (Specify below)
 2 Irrigation 4 Industrial 7 Lawn and garden only 10 Monitoring well stock
 Was a chemical/bacteriological sample submitted to Department? Yes..... No... If yes, mo/day/yr sample was submitted
 Water Well Disinfected? Yes No

5 TYPE OF BLANK CASING USED: 5 Wrought iron 8 Concrete tile CASING JOINTS: Glued... Clamped
 1 Steel 3 RMP (SR) 6 Asbestos-Cement 9 Other (specify below) Welded
 PVC 4 ABS 7 Fiberglass Threaded
 Blank casing diameter... 5 in. to 164 ft., Dia in. to ft., Dia in. to ft.
 Casing height above land surface... 12 in., weight lbs./ft. Wall thickness or gauge No. 200 psi

TYPE OF SCREEN OR PERFORATION MATERIAL: PVC 10 Asbestos-cement
 1 Steel 3 Stainless steel 5 Fiberglass 8 RMP (SR) 11 Other (specify)
 2 Brass 4 Galvanized steel 6 Concrete tile 9 ABS 12 None used (open hole)

SCREEN OR PERFORATION OPENINGS ARE: 5 Gauzed wrapped Saw cut 11 None (open hole)
 1 Continuous slot 3 Mill slot 6 Wire wrapped 9 Drilled holes
 2 Louvered shutter 4 Key punched 7 Torch cut 10 Other (specify)

SCREEN-PERFORATED INTERVALS: From... 144 ft. to 164 ft., From ft. to ft.
 From ft. to ft., From ft. to ft.
 GRAVEL PACK INTERVALS: From... 20 ft. to 164 ft., From ft. to ft.
 From ft. to ft., From ft. to ft.

6 GROUT MATERIAL: 1 Neat cement 2 Cement grout Bentonite 4 Other
 Grout Intervals: From... 0 ft. to 20 ft., From ft. to ft., From ft. to ft.

What is the nearest source of possible contamination:
 Septic tank 4 Lateral lines 7 Pit privy 10 Livestock pens 14 Abandoned water well
 2 Sewer lines 5 Cess pool 8 Sewage lagoon 11 Fuel storage 15 Oil well/Gas well
 3 Watertight sewer lines 6 Seepage pit 9 Feedyard 12 Fertilizer storage 16 Other (specify below)
 13 Insecticide storage
 Direction from well? How many feet? 100

FROM	TO	LITHOLOGIC LOG	FROM	TO	PLUGGING INTERVALS
0	1	top soil			
1	20	brown clay			
20	21	medium to coarse sand			
21	29	brown clay			
29	46	medium to coarse sand & gravel			
46	71	brown clay & gypsum			
71	91	medium to coarse sand			
91	96	brown clay			
96	107	medium to coarse sand & small gravel			
107	122	brown clay			
122	142	fine sand, clay streaks			
142	145	brown clay			
145	157	medium to coarse sand & small gravel			
157	162	brown clay			

7 CONTRACTOR'S OR LANDOWNER'S CERTIFICATION: This water well was constructed, (2) reconstructed, or (3) plugged under my jurisdiction and was completed on (mo/day/year) ... 5-31-96 ... and this record is true to the best of my knowledge and belief. Kansas
 Water Well Contractor's License No. ... 532 ... This Water Well Record was completed on (mo/day/yr) ... 6-3-96 ...
 under the business name of Midwest Well & Pump by (signature) Victor Sankup

OFFICE USE ONLY
T
R
EW
SEC.