


1 LOCATION OF WATER WELL: Fraction SW 1/4 SW 1/4 SW 1/4 Section Number 18 Township Number T 24 S Range Number R 36 E/W
 County: Kearny
 Distance and direction from nearest town or city street address of well if located within city?

2 WATER WELL OWNER: Harold Loepke
 RR#, St. Address, Box # : 504 Bopp Blvd. Board of Agriculture, Division of Water Resources
 City, State, ZIP Code : Lakin, Ks. 67860 Application Number:

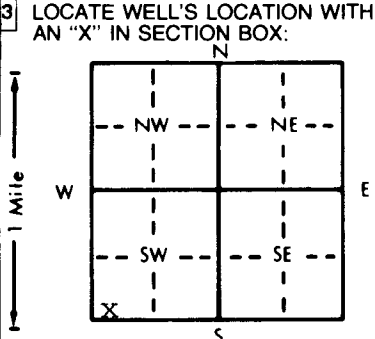

4 DEPTH OF COMPLETED WELL... 201 ft. ELEVATION:
 Depth(s) Groundwater Encountered 1. ft. 2. ft. 3. ft.
 WELL'S STATIC WATER LEVEL... 184'6" ft. below land surface measured on mo/day/yr... 5-31-96
 Pump test data: Well water was ft. after hours pumping gpm
 Est. Yield... 6 gpm: Well water was ft. after hours pumping gpm
 Bore Hole Diameter... 10 in. to... 201 ft., and... in. to ft.
 WELL WATER TO BE USED AS: 5 Public water supply 8 Air conditioning 11 Injection well
 1 Domestic 3 Feedlot 6 Oil field water supply 9 Dewatering Other (Specify below)
 2 Irrigation 4 Industrial 7 Lawn and garden only 10 Monitoring well stock
 Was a chemical/bacteriological sample submitted to Department? Yes.....No.....; If yes, mo/day/yr sample was submitted
 Water Well Disinfected? Yes No

5 TYPE OF BLANK CASING USED: 5 Wrought iron 8 Concrete tile CASING JOINTS: Glued...... Clamped...
 1 Steel 3 RMP (SR) 6 Asbestos-Cement 9 Other (specify below) Welded...
 PVC 4 ABS 7 Fiberglass Threaded...
 Blank casing diameter... 5 in. to... 201 ft., Dia... in. to... ft., Dia... in. to... ft.
 Casing height above land surface... 12 in., weight... lbs./ft. Wall thickness or gauge No. 200 psi
 TYPE OF SCREEN OR PERFORATION MATERIAL: PVC 10 Asbestos-cement
 1 Steel 3 Stainless steel 5 Fiberglass 8 RMP (SR) 11 Other (specify)
 2 Brass 4 Galvanized steel 6 Concrete tile 9 ABS 12 None used (open hole)
 SCREEN OR PERFORATION OPENINGS ARE: 5 Gauzed wrapped Saw cut 11 None (open hole)
 1 Continuous slot 3 Mill slot 6 Wire wrapped 9 Drilled holes
 2 Louvered shutter 4 Key punched 7 Torch cut 10 Other (specify)
 SCREEN-PERFORATED INTERVALS: From... 181 ft. to... 201 ft., From... ft. to... ft.
 From... ft. to... ft., From... ft. to... ft.
 GRAVEL PACK INTERVALS: From... 20 ft. to... 201 ft., From... ft. to... ft.
 From... ft. to... ft., From... ft. to... ft.

6 GROUT MATERIAL: 1 Neat cement 2 Cement grout Bentonite 4 Other
 Grout Intervals: From... 0 ft. to... 20 ft., From... ft. to... ft., From... ft. to... ft.
 What is the nearest source of possible contamination:
 Septic tank 4 Lateral lines 7 Pit privy 10 Livestock pens 14 Abandoned water well
 2 Sewer lines 5 Cess pool 8 Sewage lagoon 11 Fuel storage 15 Oil well/Gas well
 3 Watertight sewer lines 6 Seepage pit 9 Feedyard 12 Fertilizer storage 16 Other (specify below)
 13 Insecticide storage
 Direction from well? How many feet? 100

FROM	TO	LITHOLOGIC LOG	FROM	TO	PLUGGING INTERVALS
0	1	top soil			
1	21	brown clay			
21	41	medium to coarse sand & gravel			
41	75	brown clay & gypsum			
75	102	medium to coarse sand & gravel			
102	114	brown clay			
114	130	medium to coarse sand, cemented			
130	149	brown clay			
149	152	fine to medium sand			
152	174	brown clay			
174	192	medium to coarse sand, small gravel, few clay streaks			
192	197	brown clay			
197	200	brown clay, few sand streaks			
200	201	gray shale			

7 CONTRACTOR'S OR LANDOWNER'S CERTIFICATION: This water well was constructed, (2) reconstructed, or (3) plugged under my jurisdiction and was completed on (mo/day/year) 5-31-96 and this record is true to the best of my knowledge and belief. Kansas Water Well Contractor's License No. 532 This Water Well Record was completed on (mo/day/yr) 6-3-96 under the business name of Midwest Well & Pump by (signature) [Signature]

INSTRUCTIONS: Use typewriter or ball point pen. PLEASE PRESS FIRMLY and PRINT clearly. Please fill in blanks, underline or circle the correct answers. Send top three copies to Kansas Department of Health and Environment, Bureau of Water, Topeka, Kansas 66620-0001. Telephone: 913-296-5545. Send one to WATER WELL OWNER and retain one for your records.

OFFICE USE ONLY
T
R
EW
SEC.
1/4
1/4
1/4