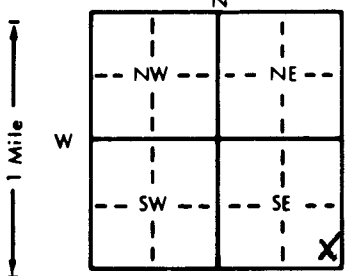


1 LOCATION OF WATER WELL: County: Kearny Fraction: SE 1/4 SE 1/4 SE 1/4 Section Number: 18 Township Number: T 24 S Range Number: R 36 E

Distance and direction from nearest town or city street address of well if located within city?

2 WATER WELL OWNER: Kearny Co. Landfill  
 RR#, St. Address, Box #: Kearny Co. Courthouse Board of Agriculture, Division of Water Resources  
 City, State, ZIP Code: Lakin, Ks. 67860 MW #2 Application Number: 3170

3 LOCATE WELL'S LOCATION WITH AN "X" IN SECTION BOX:  4 DEPTH OF COMPLETED WELL: 185 ft. ELEVATION: 3170  
 Depth(s) Groundwater Encountered 1. 162.0 ft. 2. 0 ft. 3. 0 ft.  
 WELL'S STATIC WATER LEVEL: 162.0 ft. below land surface measured on mo/day/yr  
 Pump test data: Well water was 0 ft. after 0 hours pumping 0 gpm  
 Est. Yield 0 gpm: Well water was 0 ft. after 0 hours pumping 0 gpm  
 Bore Hole Diameter: 8 in. to 185 ft., and 0 in. to 0 ft.  
 WELL WATER TO BE USED AS: 5 Public water supply 8 Air conditioning 11 Injection well  
 1 Domestic 3 Feedlot 6 Oil field water supply 9 Dewatering 12 Other (Specify below)  
 2 Irrigation 4 Industrial 7 Lawn and garden only 10 Monitoring well  
 Was a chemical/bacteriological sample submitted to Department? Yes No X No; If yes, mo/day/yr sample was submitted  
 Water Well Disinfected? Yes No X

5 TYPE OF BLANK CASING USED: 5 Wrought iron 8 Concrete tile CASING JOINTS: Glued Clamped  
 1 Steel 3 RMP (SR) 6 Asbestos-Cement 9 Other (specify below) Welded 0  
 2 PVC 4 ABS 7 Fiberglass Threaded X  
 Blank casing diameter 4 in. to 155 ft., Dia 0 in. to 0 ft., Dia 0 in. to 0 ft.  
 Casing height above land surface 24 in., weight 2,071 lbs./ft. Wall thickness or gauge No. 237  
 TYPE OF SCREEN OR PERFORATION MATERIAL: 7 PVC 10 Asbestos-cement  
 1 Steel 3 Stainless steel 5 Fiberglass 8 RMP (SR) 11 Other (specify) 0  
 2 Brass 4 Galvanized steel 6 Concrete tile 9 ABS 12 None used (open hole)  
 SCREEN OR PERFORATION OPENINGS ARE: 5 Gauzed wrapped 8 Saw cut 11 None (open hole)  
 1 Continuous slot 3 Mill slot 6 Wire wrapped 9 Drilled holes  
 2 Louvered shutter 4 Key punched 7 Torch cut 10 Other (specify) 0  
 SCREEN-PERFORATED INTERVALS: From 155 ft. to 185 ft., From 0 ft. to 0 ft.  
 From 0 ft. to 0 ft., From 0 ft. to 0 ft.  
 GRAVEL PACK INTERVALS: From 150 ft. to 185 ft., From 0 ft. to 0 ft.  
 From 0 ft. to 0 ft., From 0 ft. to 0 ft.

6 GROUT MATERIAL: 1 Neat cement 2 Cement grout 3 Bentonite 4 Other 0  
 Grout Intervals: From 0 ft. to 145 ft., From 145 ft. to 150 ft., From 0 ft. to 0 ft.  
 What is the nearest source of possible contamination:  
 1 Septic tank 4 Lateral lines 7 Pit privy 10 Livestock pens 14 Abandoned water well  
 2 Sewer lines 5 Cess pool 8 Sewage lagoon 11 Fuel storage 15 Oil well/Gas well  
 3 Watertight sewer lines 6 Seepage pit 9 Feedyard 12 Fertilizer storage 16 Other (specify below) Landfill Cells  
 13 Insecticide storage  
 Direction from well? North How many feet? 50

FROM	TO	LITHOLOGIC LOG	FROM	TO	PLUGGING INTERVALS
0	4	Sand & Clay Fill	75	83	Sand w/Clay Strks.
4	15	Sandy Clay w/Some Caliche St.	83	96	Clay w/Sand Strks.
15	22	Sand w/Cemented Sand Strks.	96	109	Med. Sand
22	27	Cemented Sand & Sand Strks.	109	110	Cemented Sand
27	46	Sand w/Some Silty Stuff	110	115	Med. Sand & Cemented Sand
46	48	Cemented Sand	115	117	Clay Strks.
48	53	Sand	117	127	Cemented Sand, Clay & Sand
53	55	Sand w/Cemented Sand Strks.	127	135	Clay
55	57	Cemented Sand w/Sand Strks.	135	145	Clay w/Sand Strks.
57	61	Sand w/Cemented Sand Strks.	145	154	Sand w/Fine Clay Lyrs.
61	62	Caliche	154	156	Clay
62	64	Cemented Sand	156	182	Sand
64	67	Med. Sand	182	185	Clay
67	72	Med. Sand, Clay & Caliche St.			
72	75	Clay			

7 CONTRACTOR'S OR LANDOWNER'S CERTIFICATION: This water well was (1) constructed, (2) reconstructed, or (3) plugged under my jurisdiction and was completed on (mo/day/year) 2-1-94 and this record is true to the best of my knowledge and belief. Kansas Water Well Contractor's License No. 554 This Water Well Record was completed on (mo/day/yr) 2-7-94 under the business name of Woofter Pump & Well, Inc. by (signature) Gray Co. [Signature]

INSTRUCTIONS: Use typewriter or ball point pen. PLEASE PRESS FIRMLY and PRINT clearly. Please fill in blanks, underline or circle the correct answers. Send top three copies to Kansas Department of Health and Environment, Bureau of Water, Topeka, Kansas 66620-0001. Telephone: 913-296-5545. Send one to WATER WELL OWNER and retain one for your records.

OFFICE USE ONLY  
T  
R  
EAW  
SEC.  
1/4  
1/4  
1/4