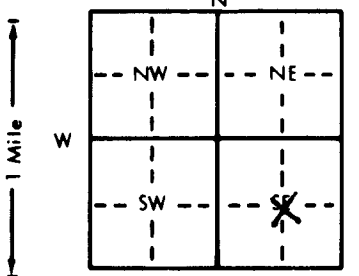


1 LOCATION OF WATER WELL: County: Kearny Fraction: C ~~XX~~ C¹/₂ 1/4 SE 1/4 Section Number: 18 Township Number: T 24 S Range Number: R 36 **EW**
 Distance and direction from nearest town or city street address of well if located within city?

2 WATER WELL OWNER: Kearny Co. Landfill
 RR#, St. Address, Box #: Kearny Co. Courthouse Board of Agriculture, Division of Water Resources
 City, State, ZIP Code: Lakin, Kansas 67860 MW #1: Application Number:

3 LOCATE WELL'S LOCATION WITH AN "X" IN SECTION BOX:  4 DEPTH OF COMPLETED WELL: 182 ft. ELEVATION: 3180
 Depth(s) Groundwater Encountered 1. ft. 2. ft. 3. ft.
 WELL'S STATIC WATER LEVEL: 162.9 ft. below land surface measured on mo/day/yr
 Pump test data: Well water was ft. after hours pumping gpm
 Est. Yield gpm: Well water was ft. after hours pumping gpm
 Bore Hole Diameter: in. to ft. and in. to ft.
 WELL WATER TO BE USED AS: 5 Public water supply 8 Air conditioning 11 Injection well
 1 Domestic 3 Feedlot 6 Oil field water supply 9 Dewatering 12 Other (Specify below)
 2 Irrigation 4 Industrial 7 Lawn and garden only 10 Monitoring well
 Was a chemical/bacteriological sample submitted to Department? Yes No X; If yes, mo/day/yr sample was submitted
 Water Well Disinfected? Yes No X

5 TYPE OF BLANK CASING USED: 1 Steel 3 RMP (SR) 5 Wrought iron 8 Concrete tile CASING JOINTS: Glued Clamped
 2 PVC 4 ABS 6 Asbestos-Cement 9 Other (specify below) Welded
 7 Fiberglass Threaded X
 Blank casing diameter 4 in. to 152 ft., Dia in. to ft., Dia in. to ft.
 Casing height above land surface 24 in., weight 2,071 lbs./ft. Wall thickness or gauge No. 237
 TYPE OF SCREEN OR PERFORATION MATERIAL: 7 PVC 10 Asbestos-cement
 1 Steel 3 Stainless steel 5 Fiberglass 8 RMP (SR) 11 Other (specify)
 2 Brass 4 Galvanized steel 6 Concrete tile 9 ABS 12 None used (open hole)
 SCREEN OR PERFORATION OPENINGS ARE: 5 Gauzed wrapped 8 Saw cut 11 None (open hole)
 1 Continuous slot 3 Mill slot 6 Wire wrapped 9 Drilled holes
 2 Louvered shutter 4 Key punched 7 Torch cut 10 Other (specify)
 SCREEN-PERFORATED INTERVALS: From 152 ft. to 182 ft., From ft. to ft.
 From ft. to ft., From ft. to ft.
 GRAVEL PACK INTERVALS: From 145 ft. to 182 ft., From ft. to ft.
 From ft. to ft., From ft. to ft.

6 GROUT MATERIAL: 1 Neat cement 2 Cement grout 3 Bentonite 4 Other
 Grout Intervals: From 0 ft. to 140 ft., From 140 ft. to 145 ft., From ft. to ft.
 What is the nearest source of possible contamination:
 1 Septic tank 4 Lateral lines 7 Pit privy 10 Livestock pens 14 Abandoned water well
 2 Sewer lines 5 Cess pool 8 Sewage lagoon 11 Fuel storage 15 Oil well/Gas well
 3 Watertight sewer lines 6 Seepage pit 9 Feedyard 12 Fertilizer storage 16 Other (specify below)
 13 Insecticide storage Landfill Cells
 Direction from well? How many feet? 75

FROM	TO	LITHOLOGIC LOG	FROM	TO	PLUGGING INTERVALS
0	2	Surface	87	97	Sand & Some Fine Clay Lyrs.
2	8	Clay	97	98	Sandy Clay
8	13	Clay w/Sand Strks.	98	113	Med. Sand w/Fine Clay Lyrs.
13	14	Clay, Caliche w/Sand Strks.	113	114	Cemented Sand
14	20	Med. Sand w/Caliche Strks.	114	121	Med. Sand w/Some Fine ClayLy
20	41	Sandy Clay & Caliche w/Sand Strks.	121	156	Hard Sandy Clay w/SomeSand
41	45	Fine Sand	156	160	Sand
45	47	Cemented Sand w/some Sand	160	167	Sand & Clay Mix
47	55	Fine Sand w/Cemented Sand St.	167	174	Sand
55	58.5	Fine Sand	174	176	Clay W/Sand Strks.
58.5	62	Very Hard Caliche	176	183	Sand w/Clay Strks.
62	68	Tight Sand	183	186	Tight Sand & Clay
68	70	Med. Sand			
70	79	Cemented Sand			
79	87	Clay			

7 CONTRACTOR'S OR LANDOWNER'S CERTIFICATION: This water well was (1) constructed, (2) reconstructed, or (3) plugged under my jurisdiction and was completed on (mo/day/year) 2-2-94 and this record is true to the best of my knowledge and belief. Kansas Water Well Contractor's License No. 554. This Water Well Record was completed on (mo/day/yr) 2-7-94 under the business name of Woofter Pump & Well, Inc. by (signature) Jay G. Woofter

INSTRUCTIONS: Use typewriter or ball point pen. PLEASE PRESS FIRMLY and PRINT clearly. Please fill in blanks, underline or circle the correct answers. Send top three copies to Kansas Department of Health and Environment, Bureau of Water, Topeka, Kansas 66620-0001. Telephone: 913-296-5545. Send one to WATER WELL OWNER and retain one for your records.

OFFICE USE ONLY
T
R
EW
SEC
1/4
1/4
1/4