


1 LOCATION OF WATER WELL: Fraction $S\frac{1}{2}$ $\frac{1}{4}$ $S\frac{1}{2}$ $\frac{1}{4}$ SE $\frac{1}{4}$ Section Number 18 Township Number T 24 S Range Number R 36 EW

Distance and direction from nearest town or city street address of well if located within city?

2 WATER WELL OWNER: Kearny Co. Landfill
 RR#, St. Address, Box #: Kearny Co. Courthouse Board of Agriculture, Division of Water Resources
 City, State, ZIP Code: Lakin, Ks, 67860 MW #3 Application Number:

3 LOCATE WELL'S LOCATION WITH AN "X" IN SECTION BOX: 4 DEPTH OF COMPLETED WELL... 185 ft. ELEVATION: 3176

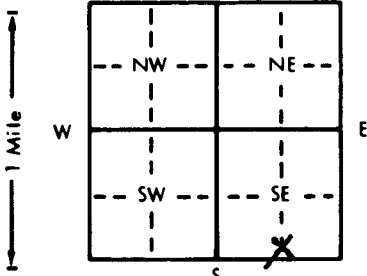

Depth(s) Groundwater Encountered 1. ft. 2. ft. 3. ft.
 WELL'S STATIC WATER LEVEL 166.4 ft. below land surface measured on mo/day/yr
 Pump test data: Well water was ft. after hours pumping gpm
 Est. Yield gpm: Well water was ft. after hours pumping gpm
 Bore Hole Diameter. . . 8 in. to . . 18.5 ft., and in. to ft.
 WELL WATER TO BE USED AS: 5 Public water supply 8 Air conditioning 11 Injection well
 1 Domestic 3 Feedlot 6 Oil field water supply 9 Dewatering 12 Other (Specify below)
 2 Irrigation 4 Industrial 7 Lawn and garden only 10 Monitoring well
 Was a chemical/bacteriological sample submitted to Department? Yes No. ; If yes, mo/day/yr sample was submitted
 Water Well Disinfected? Yes No

5 TYPE OF BLANK CASING USED: 5 Wrought iron 8 Concrete tile CASING JOINTS: Glued Clamped
 1 Steel 3 RMP (SR) 6 Asbestos-Cement 9 Other (specify below) Welded
 2 PVC 4 ABS 7 Fiberglass Threaded.
 Blank casing diameter 4 in. to . . . 15.5 ft., Dia in. to ft., Dia in. to . . . 23.7 ft.
 Casing height above land surface. . . . 24 in., weight . . . 2.071 lbs./ft. Wall thickness or gauge No.

TYPE OF SCREEN OR PERFORATION MATERIAL: 7 PVC 10 Asbestos-cement
 1 Steel 3 Stainless steel 5 Fiberglass 8 RMP (SR) 11 Other (specify)
 2 Brass 4 Galvanized steel 6 Concrete tile 9 ABS 12 None used (open hole)

SCREEN OR PERFORATION OPENINGS ARE: 5 Gauzed wrapped 8 Saw cut 11 None (open hole)
 1 Continuous slot 3 Mill slot 6 Wire wrapped 9 Drilled holes
 2 Louvered shutter 4 Key punched 7 Torch cut 10 Other (specify)

SCREEN-PERFORATED INTERVALS: From . . . 15.5 ft. to . . . 18.5 ft., From ft. to ft.
 From ft. to ft., From ft. to ft.
 GRAVEL PACK INTERVALS: From . . . 15.0 ft. to . . . 18.5 ft., From ft. to ft.
 From ft. to ft., From ft. to ft.

6 GROUT MATERIAL: 1 Neat cement 2 Cement grout 3 Bentonite 4 Other
 Grout Intervals: From 0 ft. to . . . 14.5 ft., From ft. to ft., From ft. to ft.

What is the nearest source of possible contamination:
 1 Septic tank 4 Lateral lines 7 Pit privy 10 Livestock pens 14 Abandoned water well
 2 Sewer lines 5 Cess pool 8 Sewage lagoon 11 Fuel storage 15 Oil well/Gas well
 3 Watertight sewer lines 6 Seepage pit 9 Feedyard 12 Fertilizer storage 16 Other (specify below)
 13 Insecticide storage Landfill Cells
 Direction from well? West How many feet? 75

FROM	TO	LITHOLOGIC LOG	FROM	TO	PLUGGING INTERVALS
0	2	Surface	114	116	Clay
2	12	Loess	116	126	Sand & Caliche Strks.
12	20	Clay & Caliche Strks.	126	132	Sand, Clay Caliche Mix
20	26	Med. Sand & Caliche Strks.	132	137	Clay
26	30	Cemented Sand & Sand Strks.	137	152	Sandy Clay & Caliche Strks.
30	42	Clay Cemented Sand & Sand Srk	152	153	Sand
42	51	Fine to Med. Sand w/Caliche st	153	155	Sandy Clay Caliche & Sand
51	55	Cemented Sand & Some Sand St.	155	157	Sand Strks.
55	76.5	Fine to Med. Sand&Cemented Sand	157	164	Clay
76.5	80	Cemented Sand & Sand St. St.	164	178	Sand
80	92	Caliche Cemented Sand &SandSt	178	180	Clay
92	98	Clay	180	185	Tight Sand w/Clay Strks.
98	111	Med. Sand			
111	112	Clay			
112	114	Caliche			

7 CONTRACTOR'S OR LANDOWNER'S CERTIFICATION: This water well was (1) constructed, (2) reconstructed, or (3) plugged under my jurisdiction and was completed on (mo/day/year) 2-2-94 and this record is true to the best of my knowledge and belief. Kansas Water Well Contractor's License No. 554 This Water Well Record was completed on (mo/day/yr) 2-7-94 under the business name of Woofter Pump & Well, Inc. by (signature) Jay L. Woofter

OFFICE USE ONLY T R E W SEC. 1/4 1/4 1/4