


1 LOCATION OF WATER WELL: County: **KEARNY** Fraction: **NW 1/4 SW 1/4 NW 1/4** Section Number: **26** Township Number: **T 24 S** Range Number: **R 36 EW**

Distance and direction from nearest town or city street address of well if located within city?

2 WATER WELL OWNER: **DEBORAH FREDERICK**
 RR#, St. Address, Box #: **BOX 984**
 City, State, ZIP Code: **LAKIN, KANSAS 67860**
 Board of Agriculture, Division of Water Resources
 Application Number:

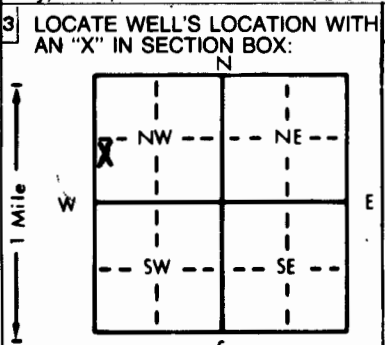

4 DEPTH OF COMPLETED WELL: **17** ft. ELEVATION: **NA**
 Depth(s) Groundwater Encountered: 1. **12** ft. 2. **NA** ft. 3. **NA** ft.
 WELL'S STATIC WATER LEVEL: **12** ft. below land surface measured on **10/30/93**
 Pump test data: Well water was **NA** ft. after **NA** hours pumping **NA** gpm
 Est. Yield: **NA** gpm Well water was **NA** ft. after **NA** hours pumping **NA** gpm
 Bore Hole Diameter: **NA** in. to **NA** ft. and **NA** in. to **NA** ft.
 WELL WATER TO BE USED AS:
 1 Domestic 3 Feedlot 6 Oil field water supply 9 Dewatering 12 Other (Specify below)
 2 Irrigation 4 Industrial 7 Lawn and garden only 10 Monitoring well
 Was a chemical/bacteriological sample submitted to Department? Yes.....No. If yes, mo/day/yr sample was submitted **NA**
 Water Well Disinfected? Yes No

5 TYPE OF RANK CASING USED:
 1 Steel 3 RMP (SR) 5 Wrought iron 8 Concrete tile CASING JOINTS: Glued Clamped
 2 PVC 4 ABS 6 Asbestos-Cement 9 Other (specify below) **TIN** Welded
 7 Fiberglass Threaded
 Blank casing diameter: **6** in. to **NA** ft. Dia. **NA** in. to **NA** ft. Dia. **NA** in. to **NA** ft.
 Casing height above land surface: **3 ft** weight **NA** lbs./ft. Wall thickness or gauge No. **NA**
 TYPE OF SCREEN OR PERFORATION MATERIAL:
 1 Steel 3 Stainless steel 5 Fiberglass 8 RMP (SR) 11 Other (specify) **NA**
 2 Brass 4 Galvanized steel 6 Concrete tile 9 ABS 12 None used (open hole)
 SCREEN OR PERFORATION OPENINGS ARE:
 1 Continuous slot 3 Mill slot 5 Gauzed wrapped 8 Saw cut 11 None (open hole)
 2 Louvered shutter 4 Key punched 6 Wire wrapped 9 Drilled holes
 7 Torch cut 10 Other (specify) **NA**
 SCREEN-PERFORATED INTERVALS: From **NA** ft. to **NA** ft. From **NA** ft. to **NA** ft. From **NA** ft. to **NA** ft.
 GRAVEL PACK INTERVALS: From **NA** ft. to **NA** ft. From **NA** ft. to **NA** ft. From **NA** ft. to **NA** ft.

6 GROUT MATERIAL: 1 Neat cement 2 Cement grout 3 **Bentonite** 4 Other
 Grout intervals: From **6** ft. to **3** ft. From **NA** ft. to **NA** ft. From **NA** ft. to **NA** ft.
 What is the nearest source of possible contamination:
 1 Septic tank 4 Lateral lines 7 Pit privy 10 Livestock pens 14 Abandoned water well
 2 Sewer lines 5 Cess pool 8 Sewage lagoon 11 Fuel storage 15 Oil well/Gas well
 3 Watertight sewer lines 6 Seepage pit 9 Feedyard 12 Fertilizer storage 16 Other (specify below) **PESTICIDE / HERBICIDE CROP SPRAYING**
 13 Insecticide storage
 Direction from well? **EAST** **NEXT TO →** How many feet?

FROM	TO	LITHOLOGIC LOG	FROM	TO	PLUGGING INTERVALS
17	12'	SAND/GRAVEL- CHLORINE			
12'	6'	DIRT/CLAY			
6'	3'	BENTONITE			
3'	0'	FILL DIRT			

7 CONTRACTOR'S OR LANDOWNER'S CERTIFICATION: This water well was (1) constructed, (2) reconstructed, or (3) **plugged** under my jurisdiction and was completed on (mo/day/year) **3/23/93** and this record is true to the best of my knowledge and belief. Kansas Water Well Contractor's License No. **NA** This Water Well Record was completed on (mo/day/yr) **4/1/93** under the business name of **DEBORAH FREDERICK** by (signature) **Deborah Frederick**